


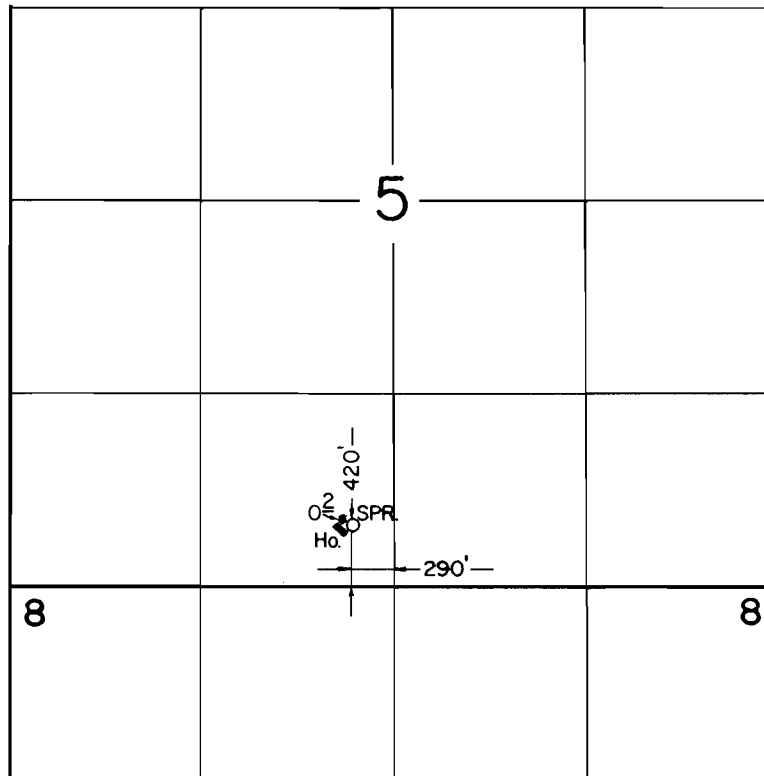

T.24S.,R.12W.,WM.



SCALE: 1" = 1320'

FINAL PROOF SURVEY
UNDER

Application No. 63185... Permit No. 46690.....
IN NAME OF

..THOMAS E. & LOLA I. DYSON.....

Surveyed SEPT. 20 1988., by ..V. L. CHURCH.....