




T.24S.,R.13W.,W.M.

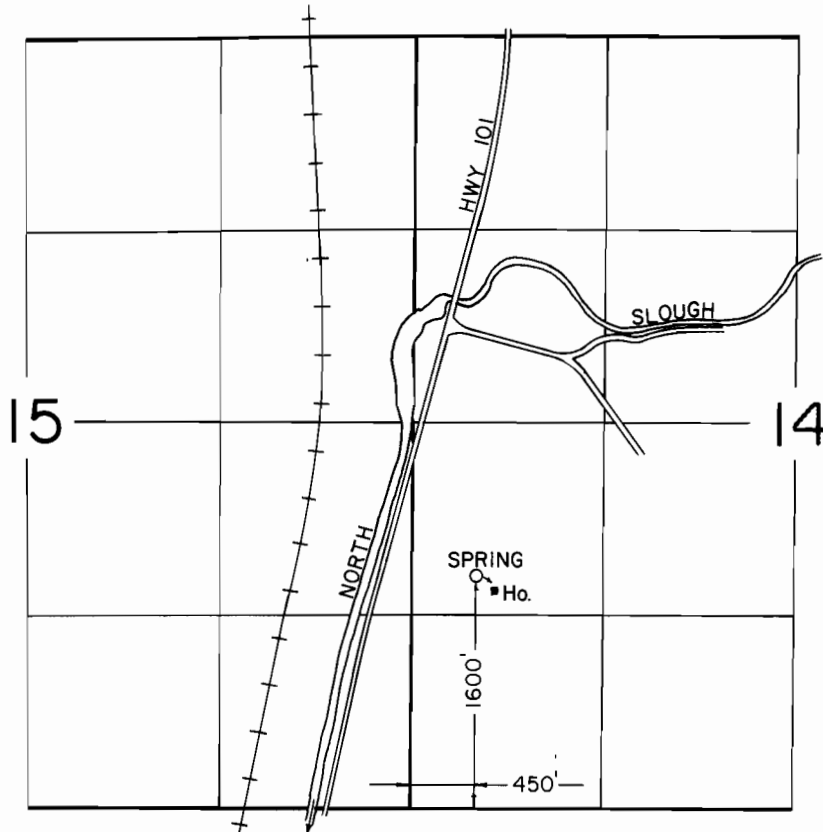

SCALE: 1" = 1320'

FINAL PROOF SURVEY
UNDER

Application No. 63524. Permit No. 46668.....

IN NAME OF

ROBERT E. LECKBAND.....

Surveyed SEPT. 20 1988, by V. L. CHURCH.....