
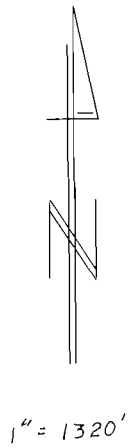


T6N, R6W, WM

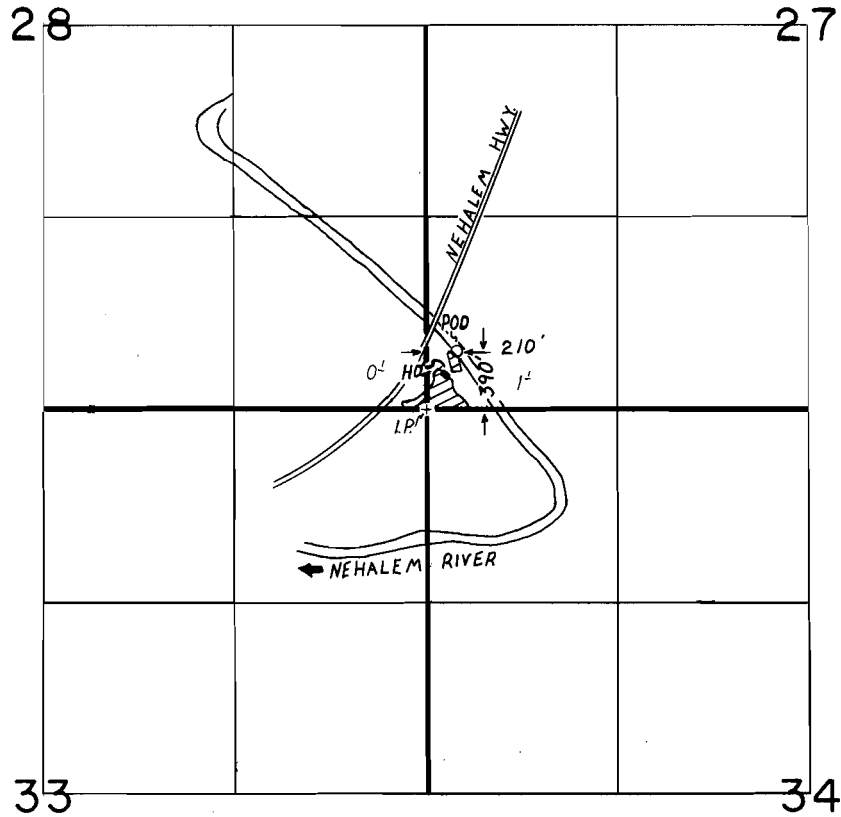

FINAL PROOF SURVEY UNDER

Application No. 6.5.7.1.7. Permit No. 4.7.7.0.6...
IN NAME OF

ROBERT E. & APRIL E.A.L. WOOD

Surveyed AUG. 17... 1988, by T. M. WARREN...