




T.23S.,R.12W.,W.M.

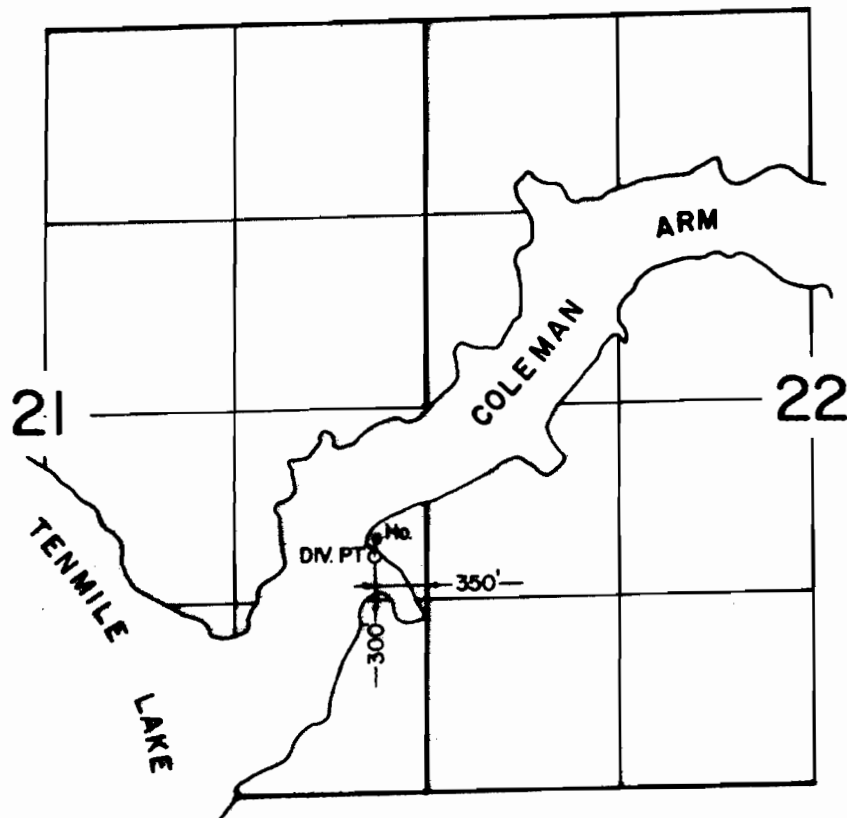

SCALE: 1" = 1320'

FINAL PROOF SURVEY
UNDER

Application No. 67943. Permit No. 48304.....
IN NAME OF

ROBERT & BEVERLY SC. PARKS.....

Surveyed SEPT. 21, 1988, by V.L. CHURCH.....