


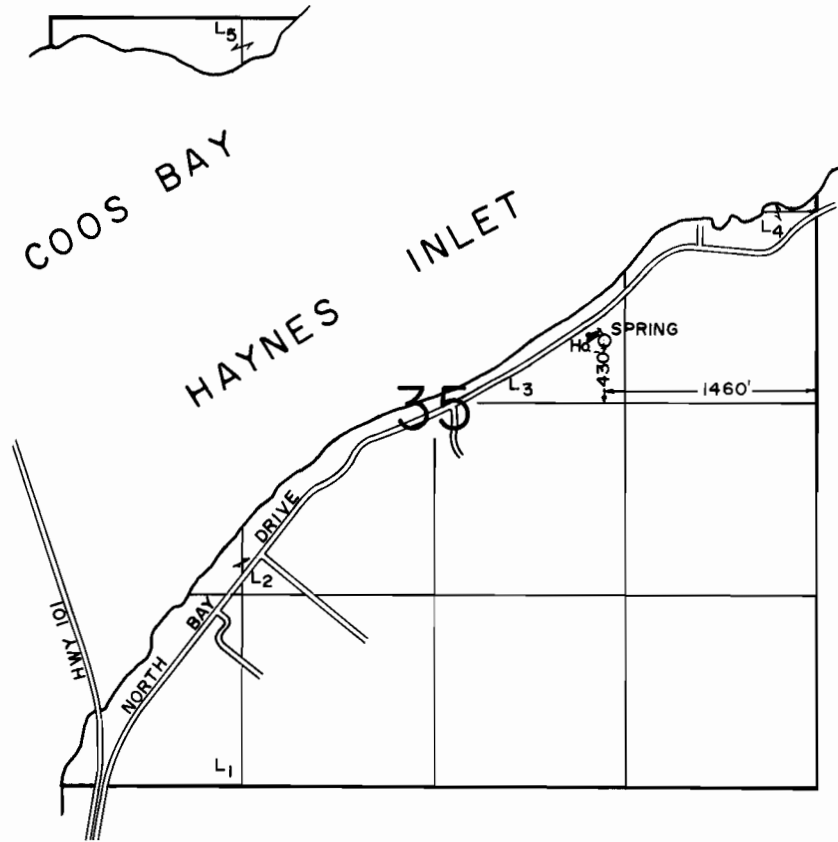

T.24S.,R.13W.,W.M.



SCALE: 1" = 1320'

**FINAL PROOF SURVEY**  
UNDER

Application No. 68380.. Permit No. 49432.....  
IN NAME OF

.....KENT W. & EDITH MAY FERRIS.....

Surveyed ..SEPT.17. 1988., by ..J.C. LARSON.....