


T.5S., R.7W., W.M.

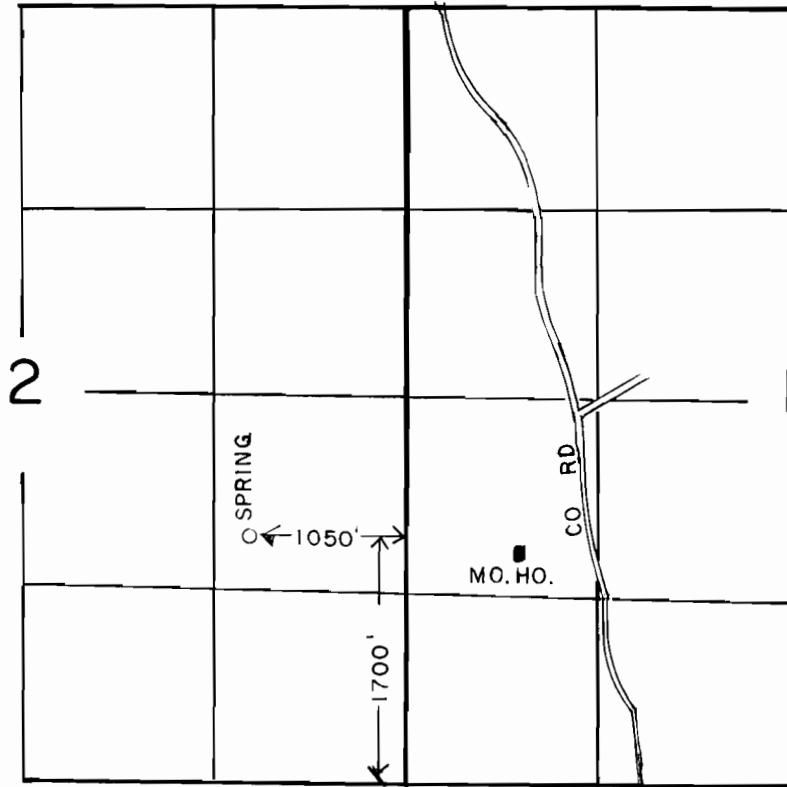

SCALE: 1"=1320'

FINAL PROOF SURVEY
UNDER

Application No. .69020. Permit No. .49974.....
IN NAME OF

....**CHAN E. & MARJORIE MENDENHALL**....

Surveyed .SEPT..18.. 1987., by .B.W..BISHOP.....