


T.2S.,R.2W.,W.M.

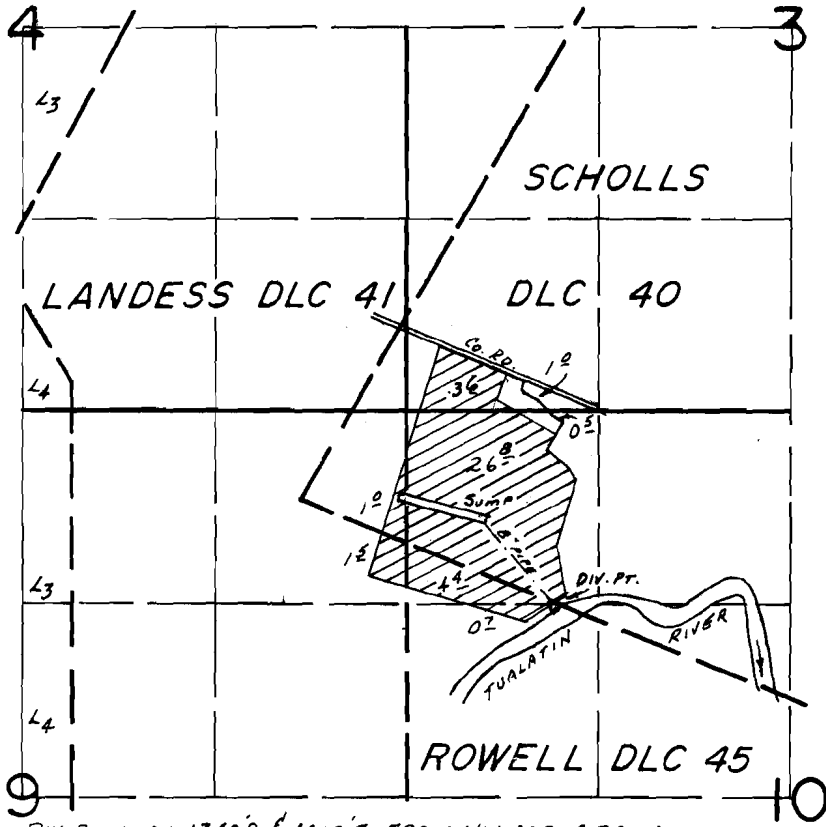

DIV. PT. LOC.: 1340'S. & 1010'E. FROM NW COR. SEC. 10
RS: 650'S & 300'E FROM NW COR. SEC. 10

SCALE: 1" = 1320'

FINAL PROOF SURVEY UNDER

R-53658 R-6275
Application No. 53659. Permit No. 39187.....
IN NAME OF

.....ROSI GOLDSMITH.....

Surveyed Mar. 31.... 1986, by T.M. WARREN.....