


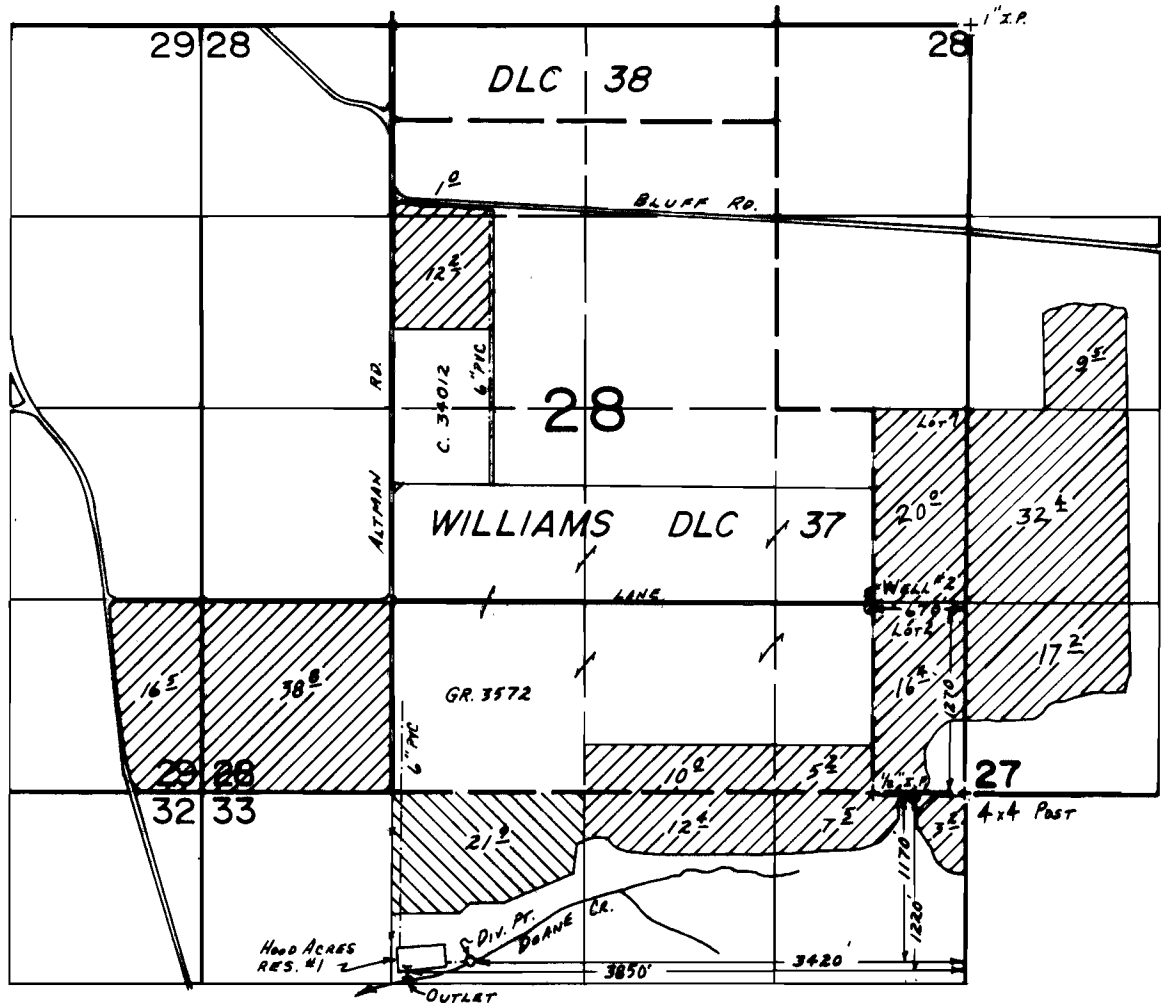


T. 1S., R. 4E., W.M.



FINAL PROOF SURVEY UNDER

 G-8117
 55882
 G-8116(SUPPL.)

R-55881 R-6645
 55882 41974
 G-8116 G-7564
 Application No. G-8117... Permit No. G-7496...
 IN NAME OF

..... J. FRANK SCHMIDT, JR.

Surveyed APR. 3... 1980, by R. G. MUCKEN.....

DFO-1LL-95
PTS 1980 H-2

A.O.D. 2/18/87 JMW