


WELL LOCATION - T 4 S, R 3 W, WM.
CITY OF DAYTON

RECEIVED
APR 14 1978
WATER RESOURCES DEPT.
SALEM, OREGON

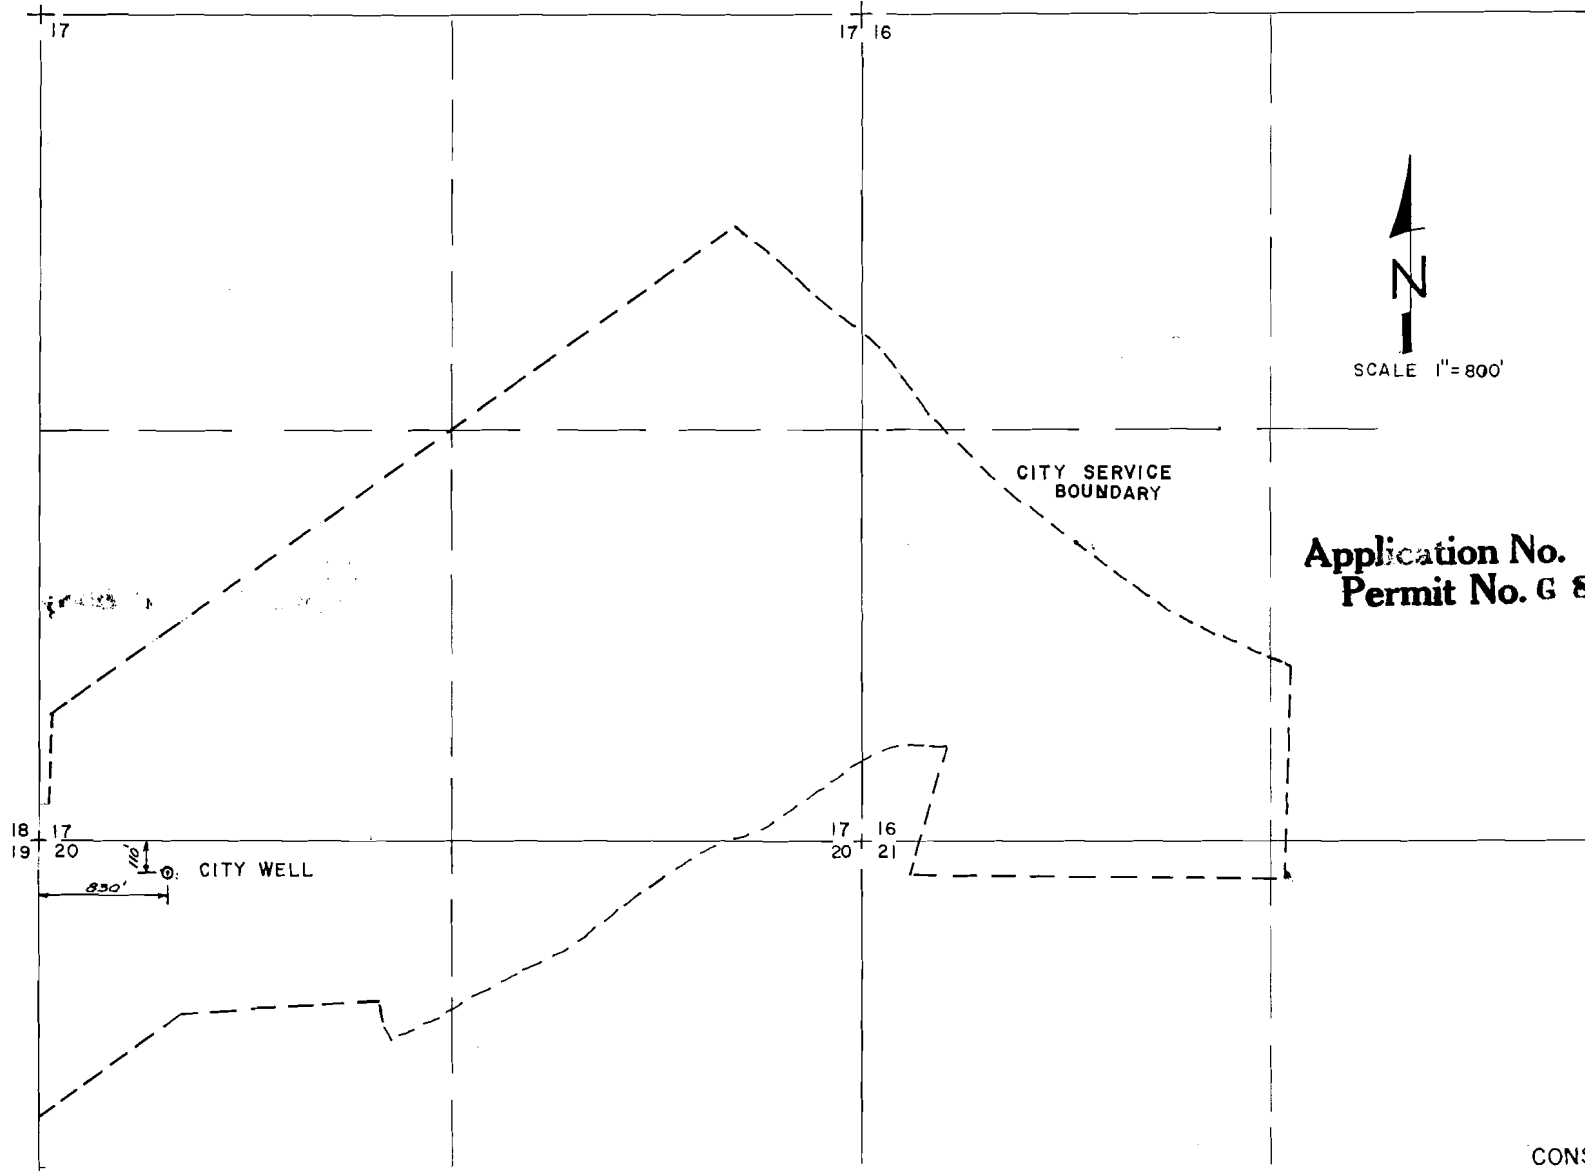

SCALE 1" = 800'



Application No. G-8735
Permit No. G 8082

CONSULTANTS NORTHWEST