


T.2N. R.12&13E. W.M.

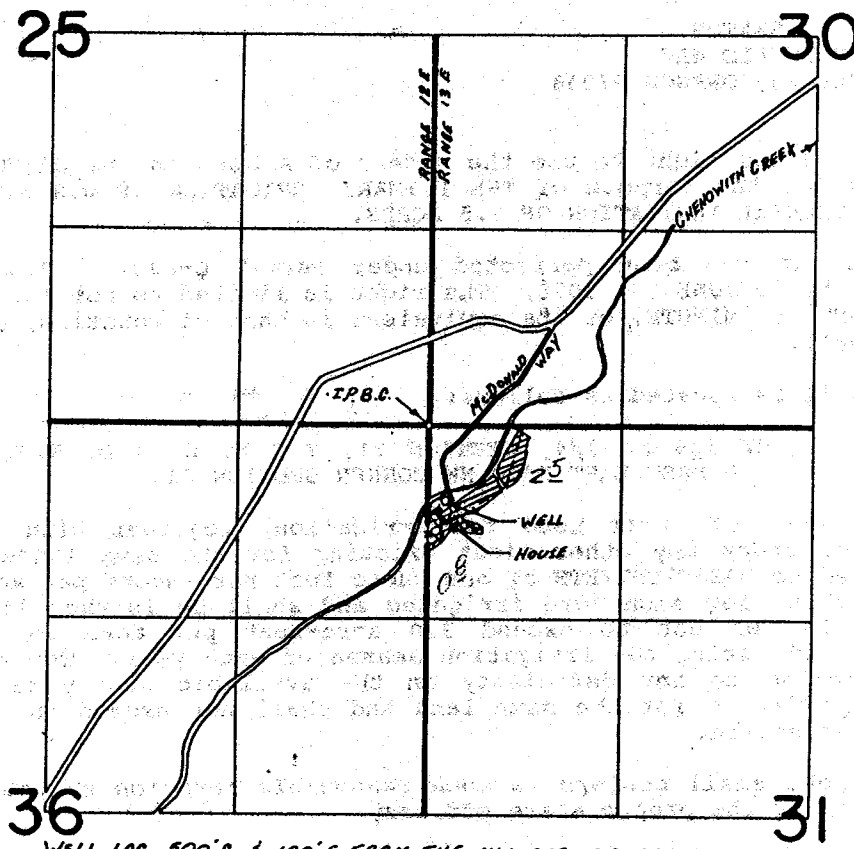

FINAL PROOF SURVEY

UNDER

Application No. G-8869 Permit No. G-8224
IN NAME OF

BRUCE W. SEXTON

Surveyed Nov. 9, 1984, by T. Paul