


T. 10S., R. 4W., W.M.

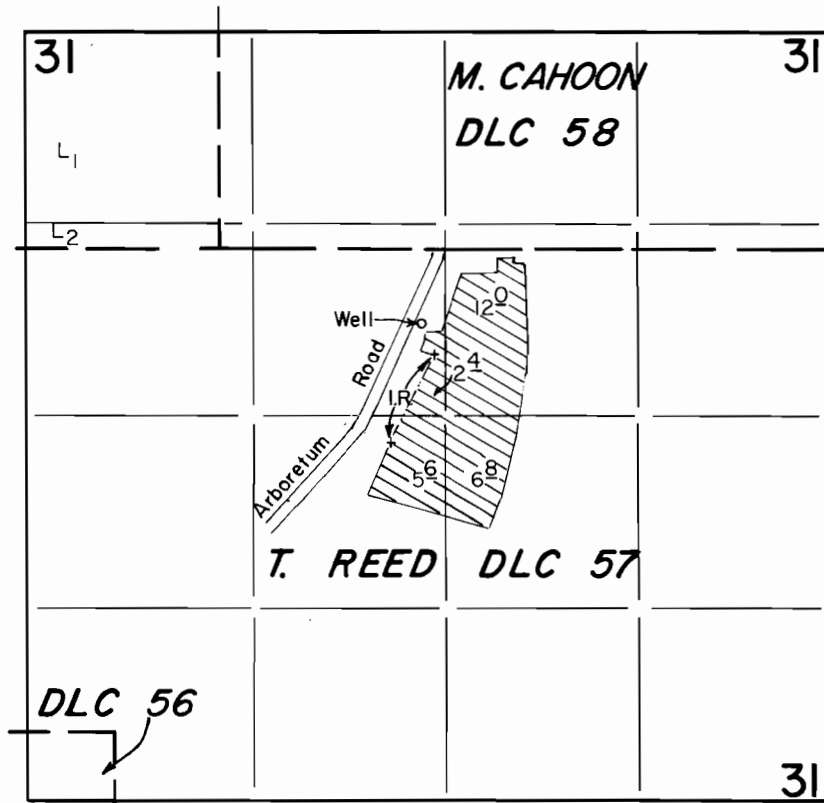

Well Loc. : 500' S. & 1390' E. from SW Cor. DLC 58.

Scale: 1" = 1320'

FINAL PROOF SURVEY UNDER

Application No. G-9509 Permit No. G-9366
IN NAME OF

WAYNE S. ANDERSON

Surveyed APRIL 22 1987., by J. Warren.....