


T.14 S., R.4 & 5W., W.M.

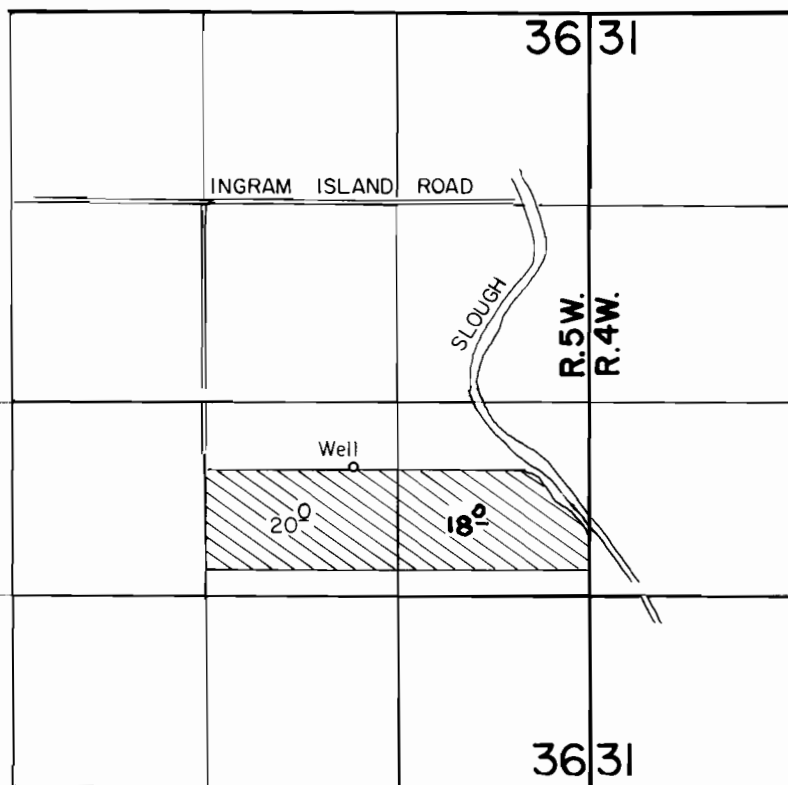

Well Loc.: **2200'** N. & **1010'** E. from S. 1/4 Cor. Sec. 36.

Scale : 1" = 1320'

FINAL PROOF SURVEY UNDER

Application No. G-9599, Permit No. G-9302.....
IN NAME OF

W. W. GRAVILLE

Surveyed **AUG 26 1988**, by **T. Warren**