


T1&2N, R14E, WM

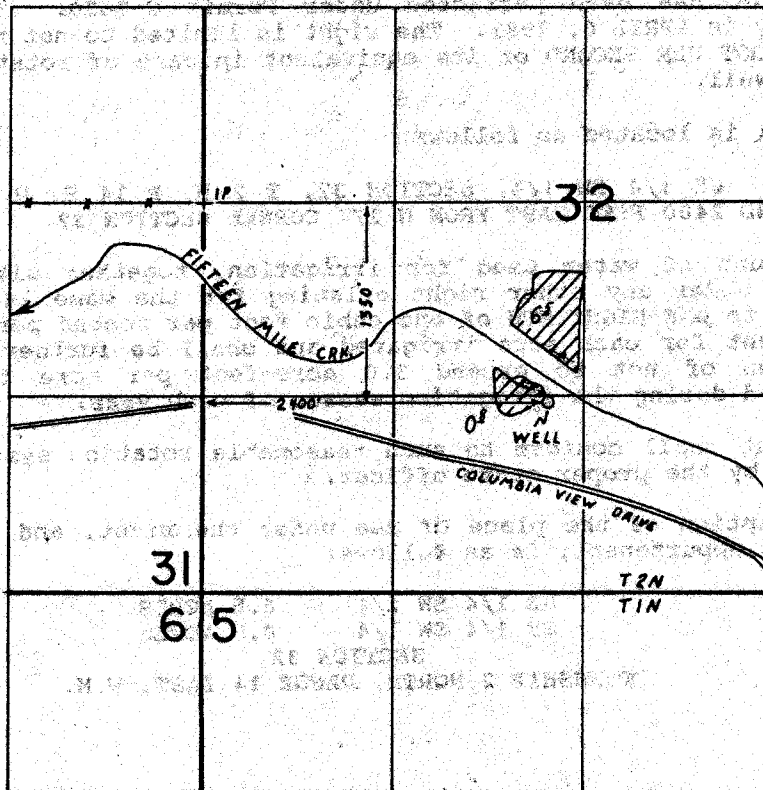

• **FINAL PROOF SURVEY**
UNDER

Application No. G-10256 Permit No. G-9630...
IN NAME OF

HARRY L. & MYRTLE P. WICKMAN

Surveyed JUNE...6.. 1988., by T..M...WARREN..