


# T.5S., R.3W., W.M.

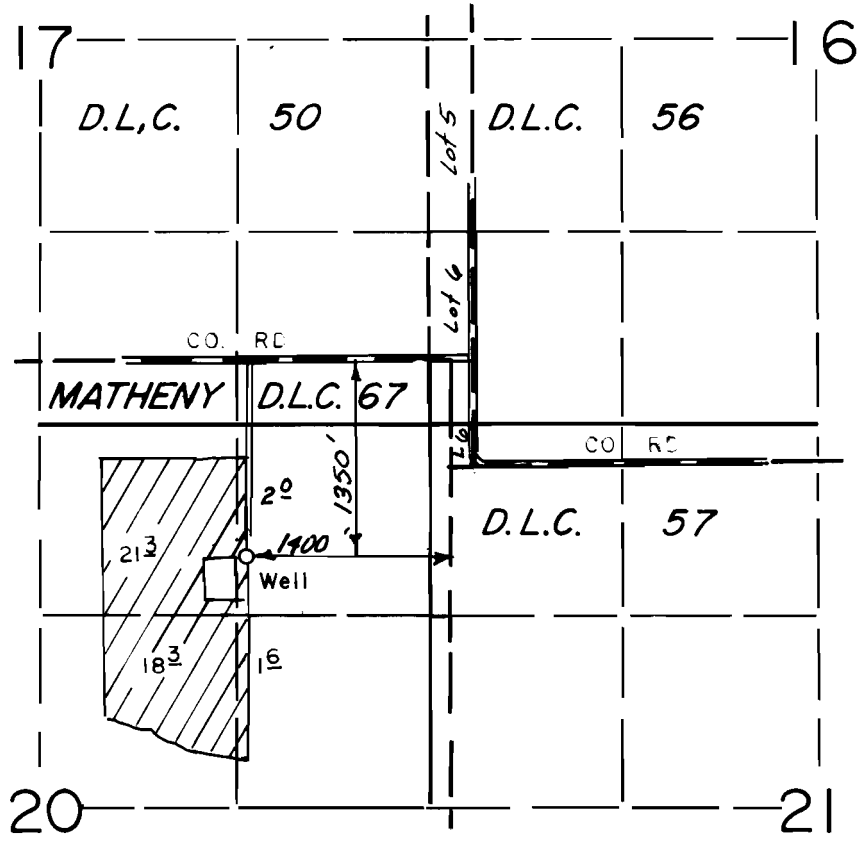

SCALE: 1" = 1320'

## FINAL PROOF SURVEY UNDER

Application No. G-10714 Permit No. G-9710  
IN NAME OF

JAMES C. & KATHERINE SHELBURNE

Surveyed JULY 9, 1987, by B.W. BISHOP