


T5S, RIW, WM

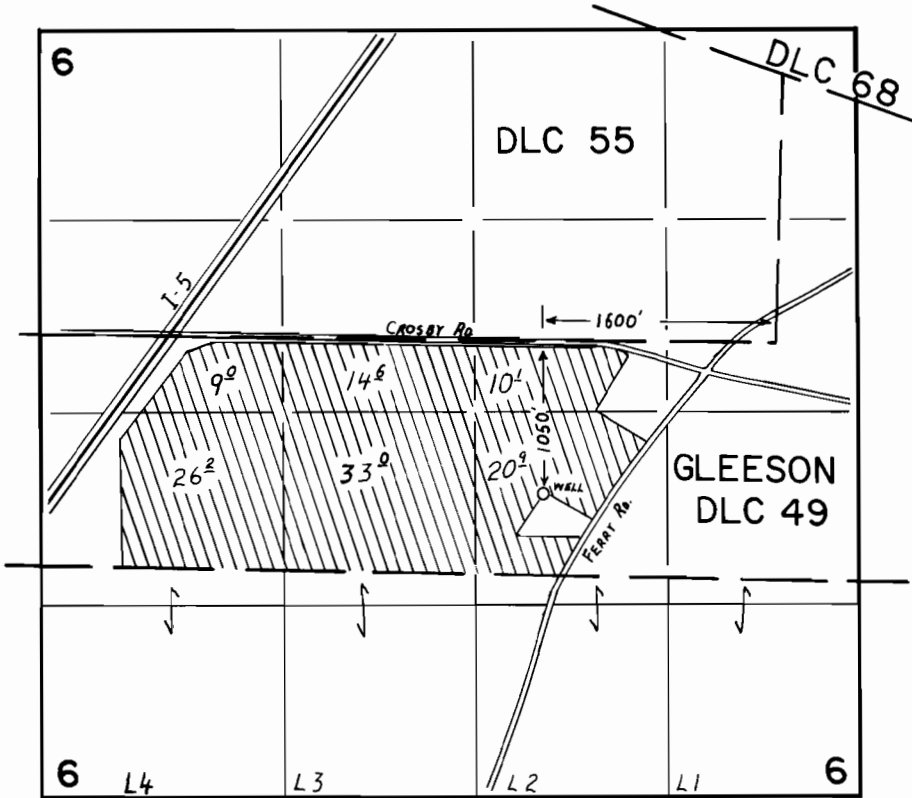

FINAL PROOF SURVEY UNDER

Application No. G-11221 Permit No. G-10311....
IN NAME OF

.....ANDREW L. HOLTZ.....

Surveyed APRIL 29 1988, by T.M. WARREN....