


# T5S, RIW, WM

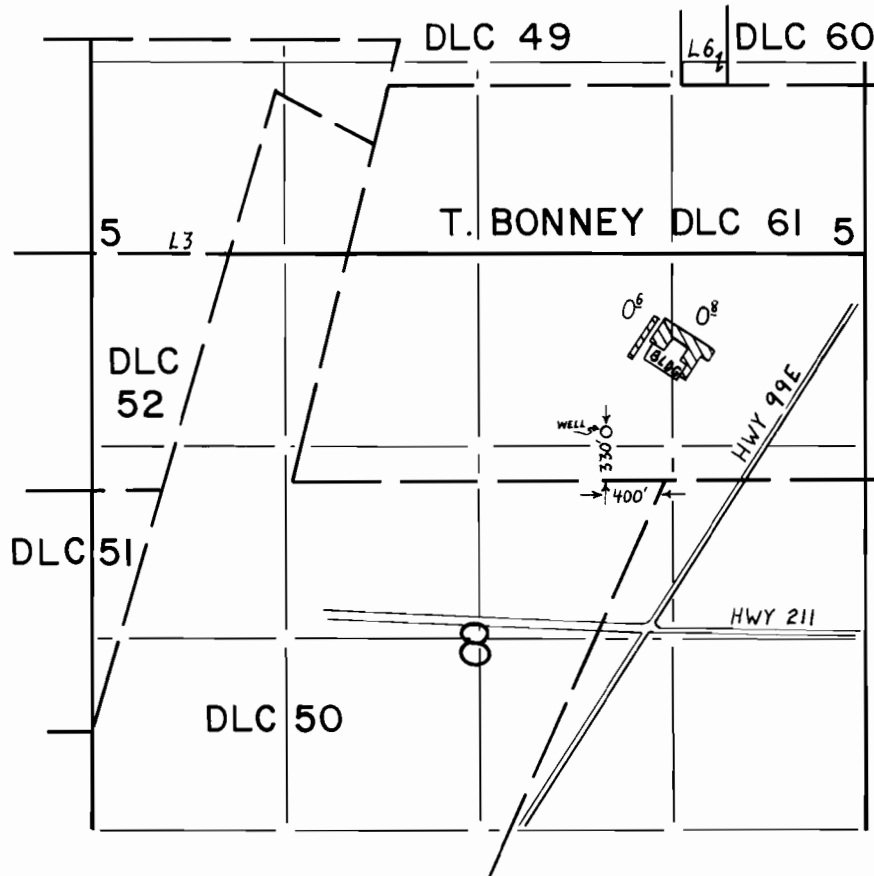

## FINAL PROOF SURVEY UNDER

Application No. G-11240 Permit No. G-10398  
IN NAME OF

THE CREDO CO.

Surveyed APRIL 28 1988, by T. M. WARREN...



SCALE  
1" = 1320'