


T. 12 S., R. 5 & 6 W., W.M.

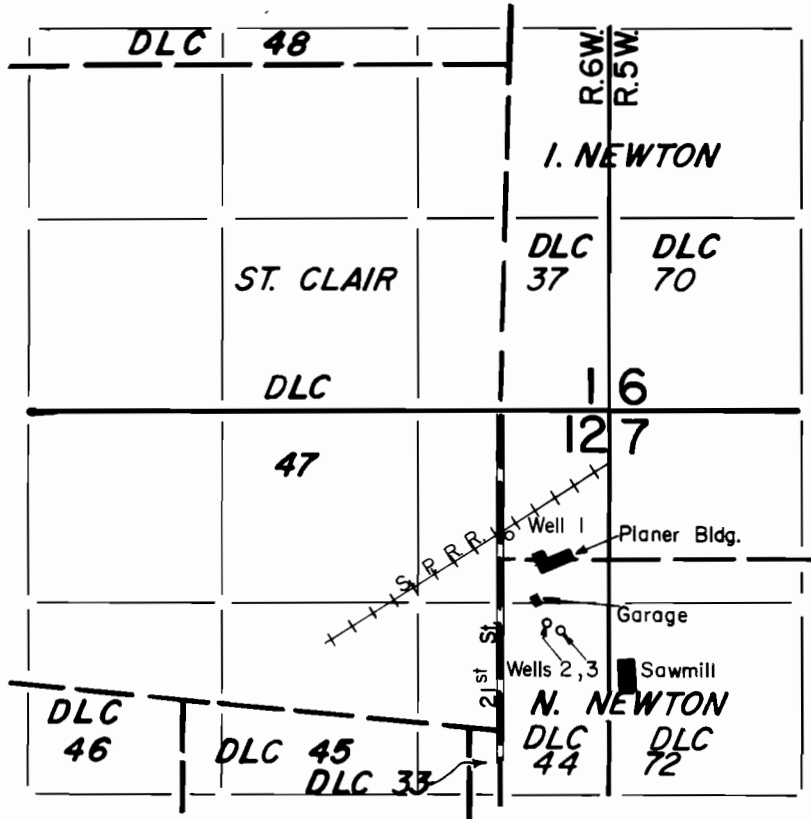

Well 1 Loc. : 150' N. & 60' E.
 Well 2 Loc. : 420' S. & 330' E.
 Well 3 Loc. : 470' S. & 430' E., all from NW Cor. N. NEWTON DLC 44.

Scale : 1" = 1320'

FINAL PROOF SURVEY UNDER

Application No. G-11428.. Permit No. G-10557.....
 IN NAME OF

PHILOMATH FOREST PRODUCTS

Surveyed May 8..... 1987., by T. Warren.....