


T.10&11S.,R.1E.,W.M.

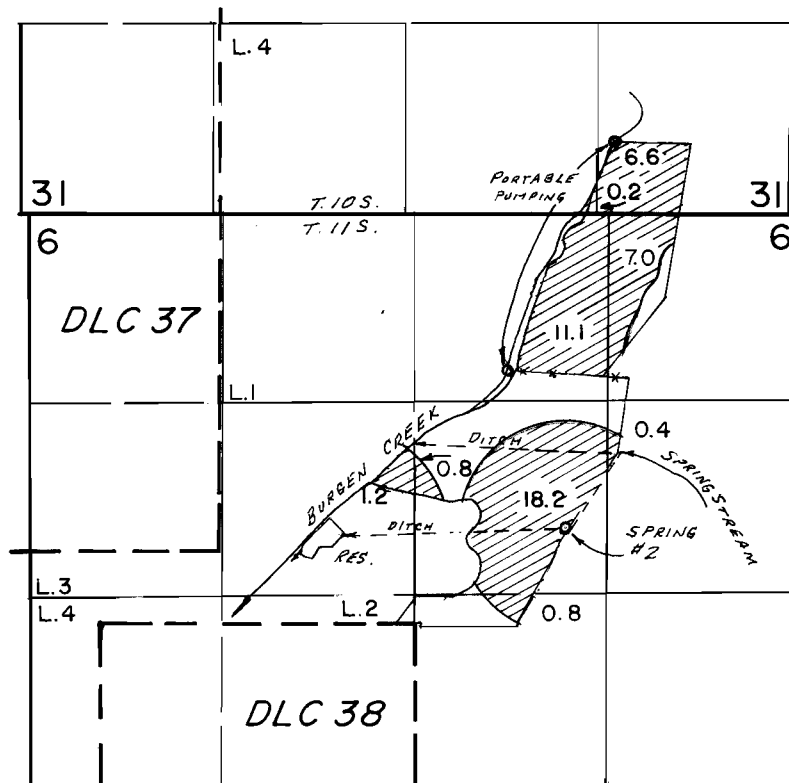

PORTABLE PUMPING BETWEEN 500' N. & 1270' W. & 1050' S. & 2000' W.
FROM NE COR. SEC. 6. SPRING #2 LOC.: 2150' S. & 1600' W. RES.
LOC.: 2330' S. & 3330' W. BOTH FROM NE COR. SEC. 6.

SCALE: 1" = 1320'

FINAL PROOF SURVEY UNDER

R-48752 R-5914
Application No. 48753. Permit No. 36566.....
IN NAME OF

RED ROBIN RANCH, DIVISION OF K-C7, INC.

Surveyed May. 23. 1986, by B.W. BISHOP.....

7/7/87 LHN

11/12/86
BWB

DFM-444-27
PTS 1986B