


T. 34 S., R. 1 W., W.M.

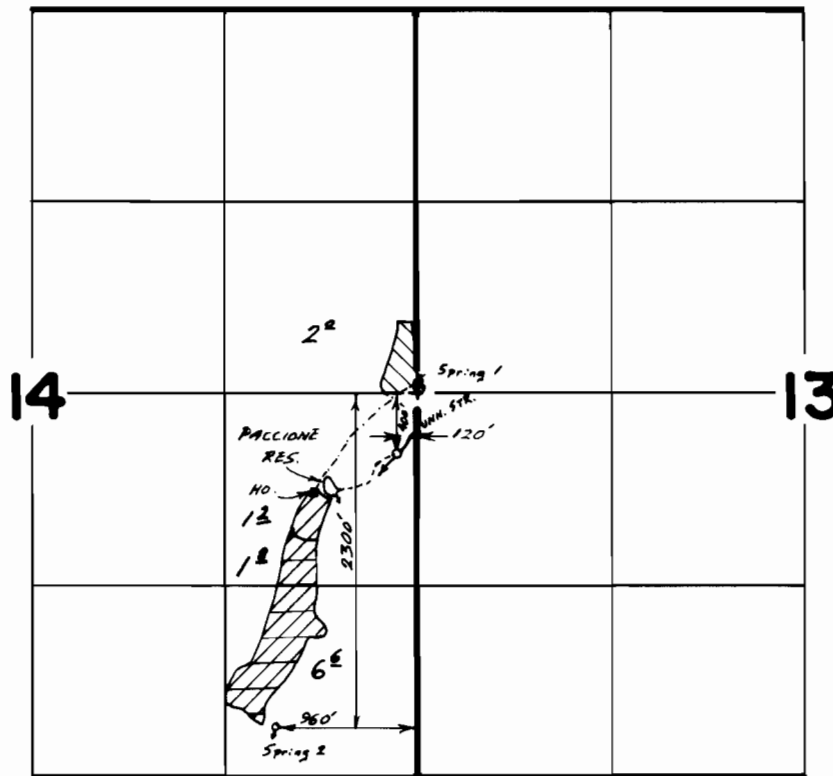

Spring 1: 80' NORTH FROM E 1/4 COR. SECTION 14.

Scale 1"=1320'

-  Spring 1
-  Reservoir
-  Spring 2

FINAL PROOF SURVEY
UNDER

R-53718

R-6432

Application No. 53719 Permit No. 40342.....
IN NAME OF

CHARLES McLAUCHLAN

Surveyed JUNE 24 1987, by B.S. JAMES