


T. 6S., R. 5W., W. M.

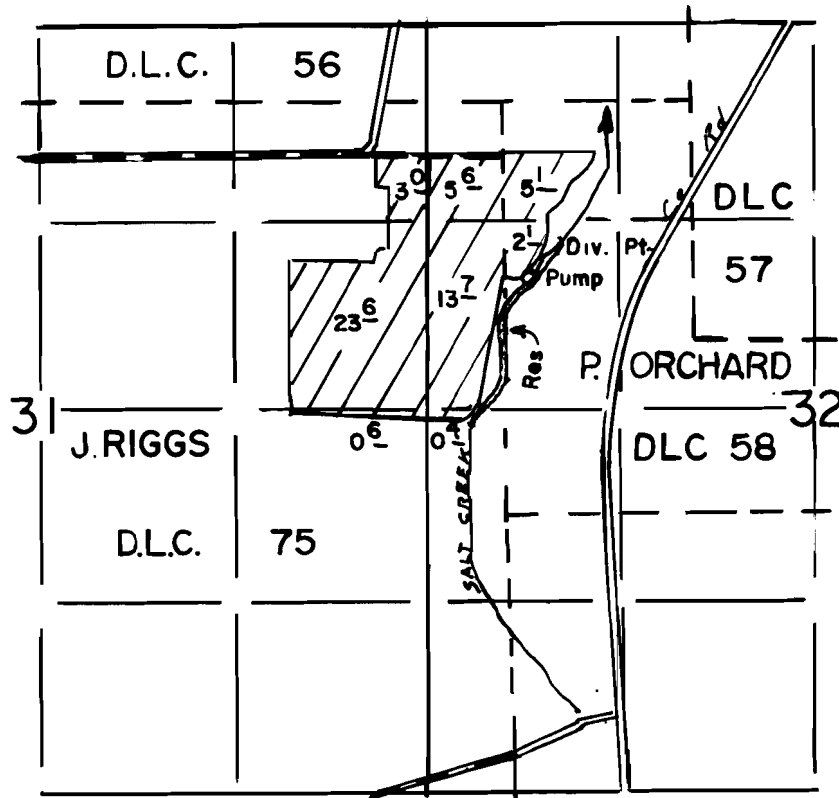

Div. Pt. Loc. 1500' S. & 900' E. From The N E Corner Section 31

SCALE: 1" = 1320'

FINAL PROOF SURVEY UNDER

R- 60674 R- 8184

Application No. 60675... Permit No. 45199.....
IN NAME OF

.....CLARENCE.....BUHLER.....

Surveyed April...24. 19.87., by B.W. BISHOP.....