


T. 2 S., R. 4 W., W.M. 1

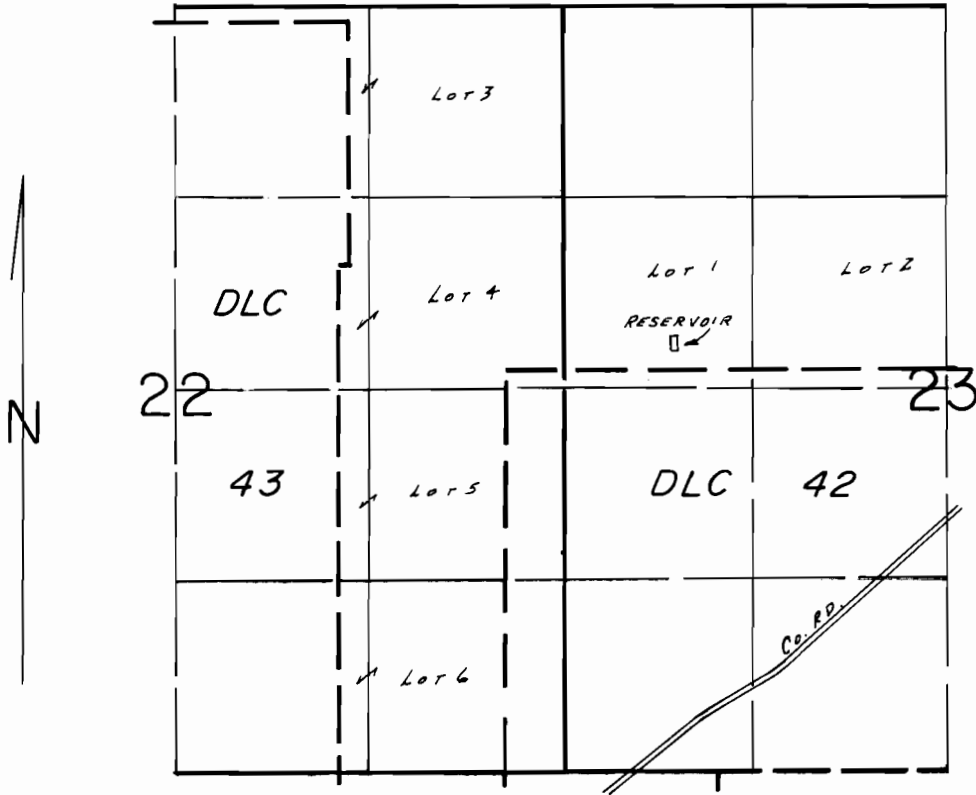

SCALE: 1" = 1320'

FINAL PROOF SURVEY
UNDER

Application No. R-63415 Permit No. R-8467.....
IN NAME OF

.....LADIS K. D. KRISTOF.....

Surveyed July 29, 1987, by B. W. BISHOP.....