


T. 8S., R. 4W., W. M.

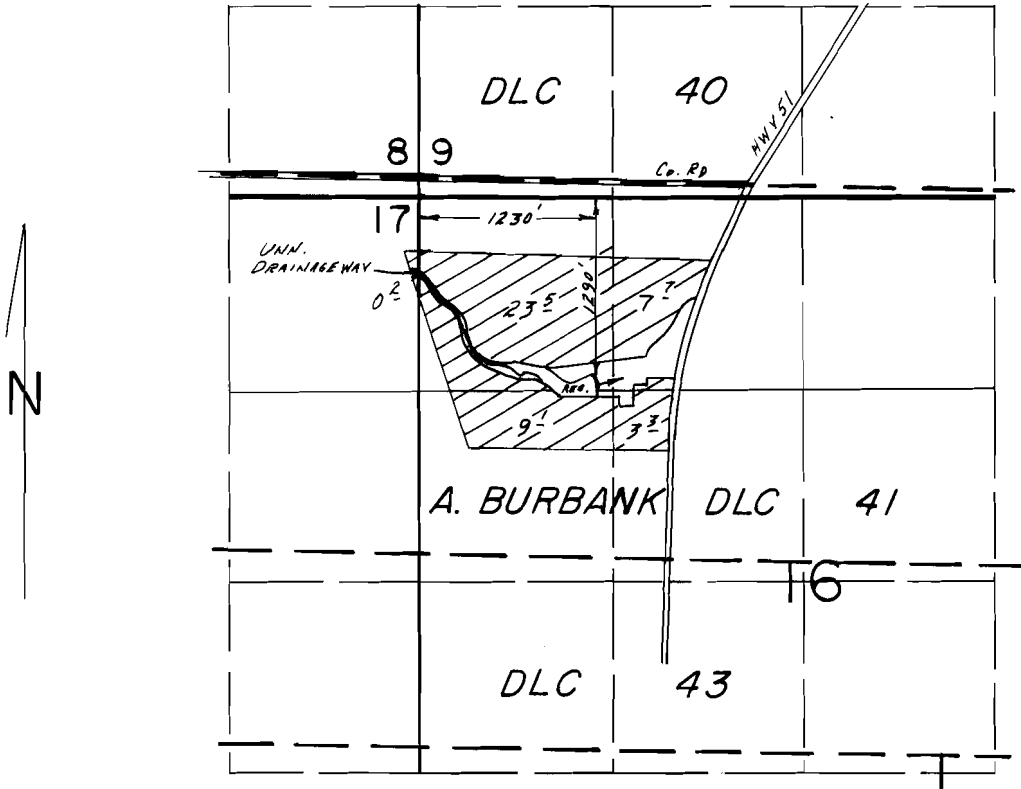

**FINAL PROOF SURVEY**  
UNDER

R-63189                      R-8476

Application No. 63190... Permit No. 46915.....

IN NAME OF

..... EDWARD O. BROWN .....

Surveyed June 18/30 19.87, by ..B.W.. BISHOP....

3/22/89  
BWB