


T. 8S., R. 4W., W. M.

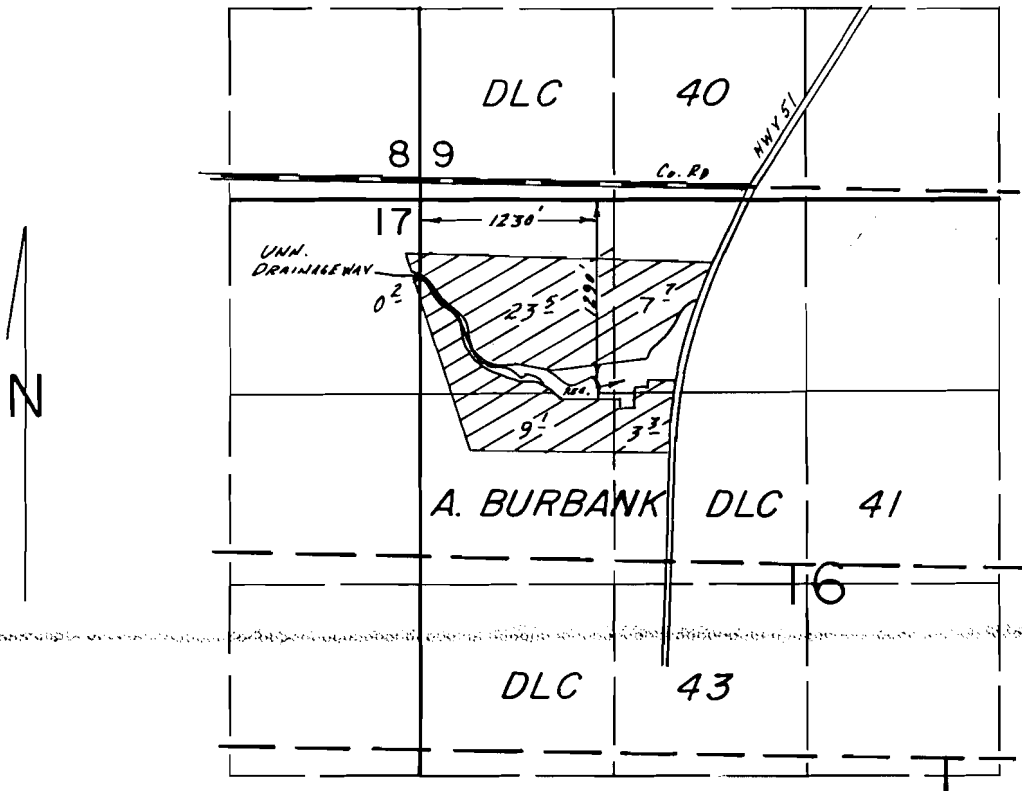

FINAL PROOF SURVEY

UNDER

R-63189

R-8476

Application No. 63190... Permit No. 46915.....

IN NAME OF

.....EDWARD O. BROWN.....

Surveyed June.18/30 19.87., by ..B.W.. BISHOP...

3/22/89
BWB