


T. 2 S., R. 2 W., W. M.

Sec. 27

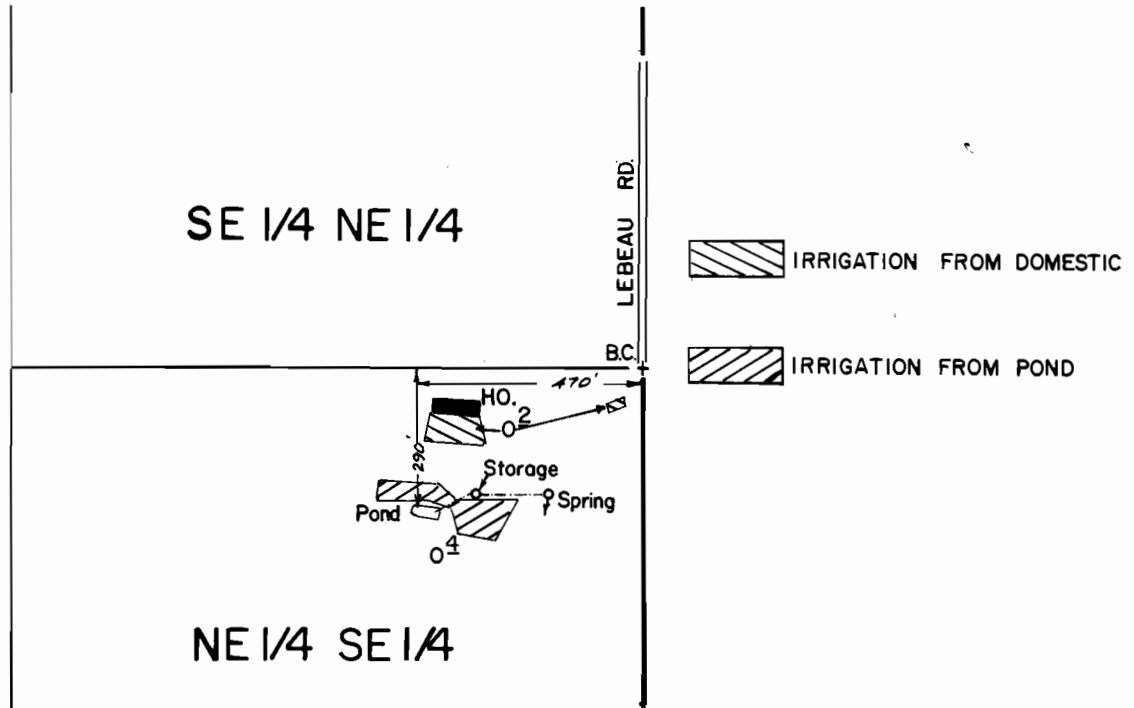

Spring Loc. : 260' S. & 200' W. from E. 1/4 Cor. Sec. 27.

Scale : 1" = 400'

FINAL PROOF SURVEY
UNDER

R-66055 R-9095
Application No. 66056 Permit No. 48075
IN NAME OF

DEL & JULIANNE L. WILLIAMS

Surveyed **JUNE 26 1988**, by **T. Warren**

PTS W/F.F.
12/8/88 TMW