


P-29205
61783

T.11S., R.35 1/2 E., W.M.
(UNSURVEYED)

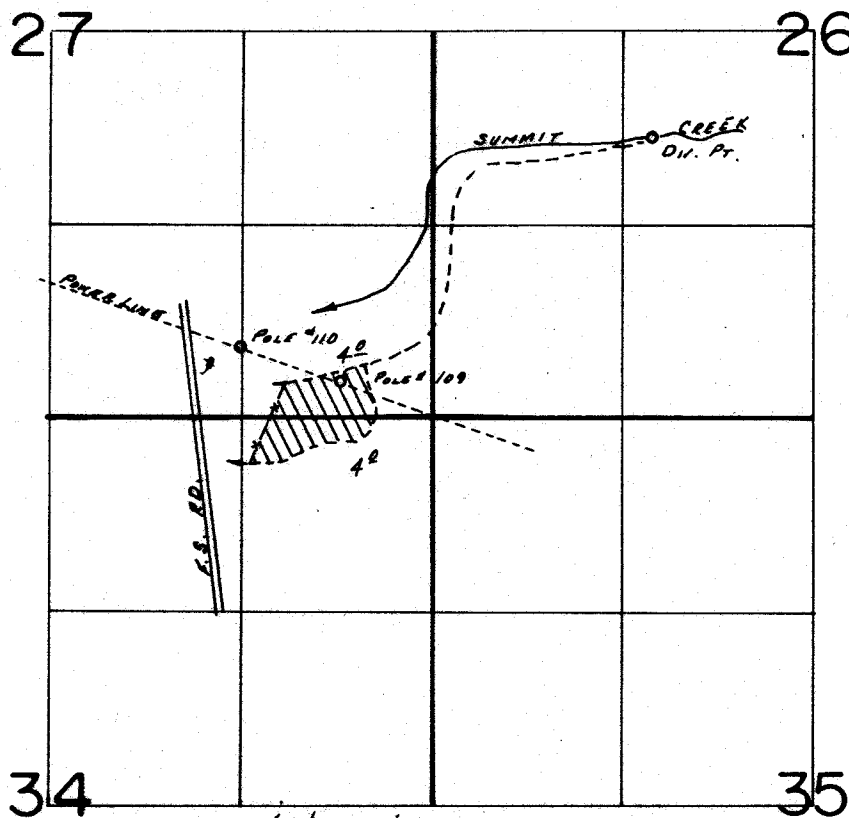

Div. Pt. Loc.: 1900 N. & 12080 E. FROM NE COR. SEC. 36, T. 11S.,
R. 35E., W.M.

SCALE: 1" = 1320'

FINAL PROOF SURVEY
UNDER

Application No. 38955.. Permit No. 29205.....
IN NAME OF

...MALHEUR NATIONAL FOREST...

Surveyed Aug. 8..... 1972, by J.E. GOULD.....
July 16 1979 S.C. BROWN

PG 1728 of 1979T

11-22-80
608