


T.7N., R.2 & 3W., W.M.

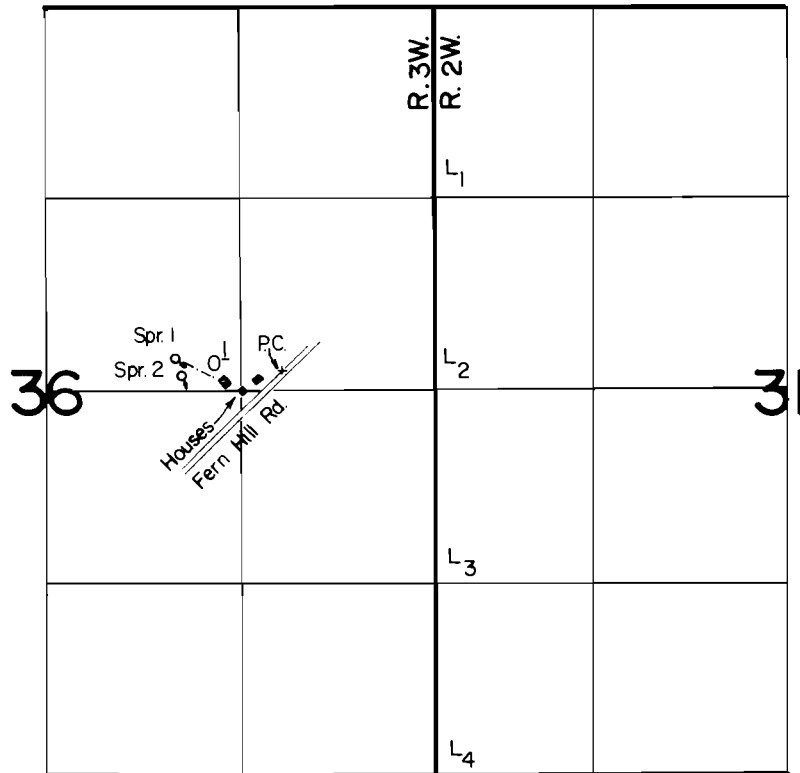

Spring 1 Loc.: 220' N. & 870' E.

Spring 2 Loc.: 90' N. & 930' E., both from C. 1/4 ; Sec. 36.

Scale: 1" = 1320'

FINAL PROOF SURVEY
UNDER

Application No. 47988... Permit No. 35955.....
IN NAME OF

ROBERT E. JENNINGS

Surveyed AUG. 14. 1986., by T. Warren.....

PTS-1906-C
8/14/87 TMW