


T. 16S. R. 3W. W.M.

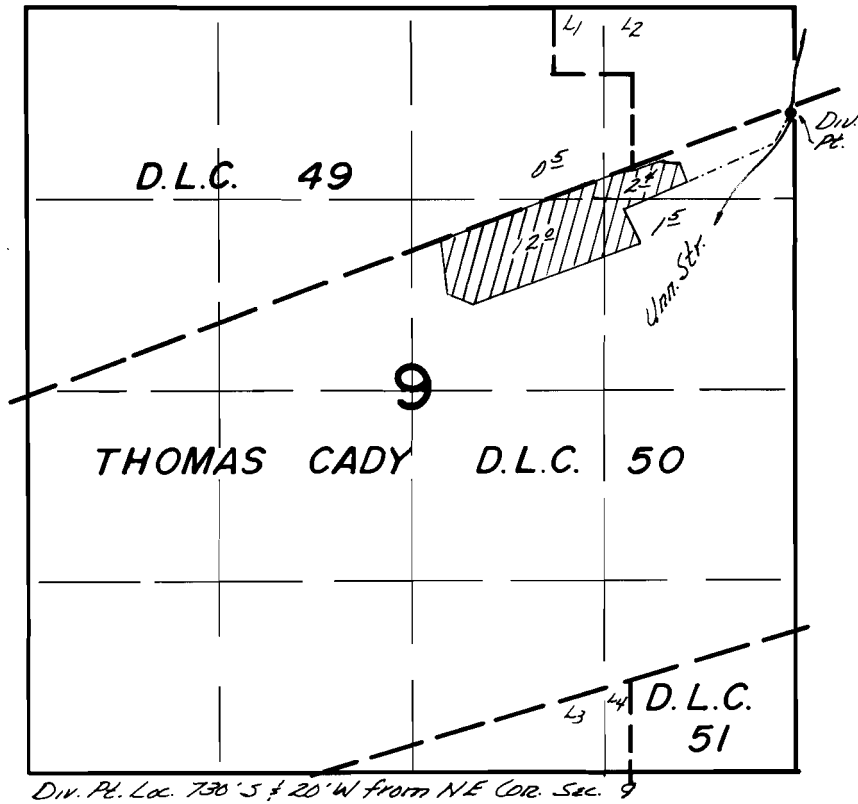

FINAL PROOF SURVEY UNDER

Application No. 4.9923... Permit No. 369.50.....
IN NAME OF

.....**MRS. MARY C. THOMAS**.....

Surveyed Oct...12... 1979., by C.R. RODRIGUEZ..