
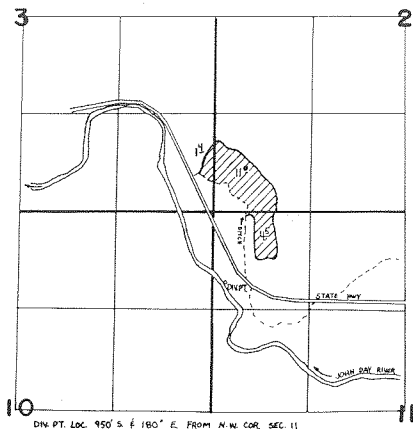


P-37162
C-61789

T. 13 S. R. 27 E. W.M.

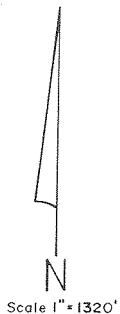

FINAL PROOF SURVEY UNDER

Application No. 51155... Permit No. 37162.....
IN NAME OF

.....**PAUL LEVATIN**.....

Surveyed April 8... 1986, by V. Chvrch.....