


# T. 25S., R. 7 W., W. M. SECTIONS 20 & 21

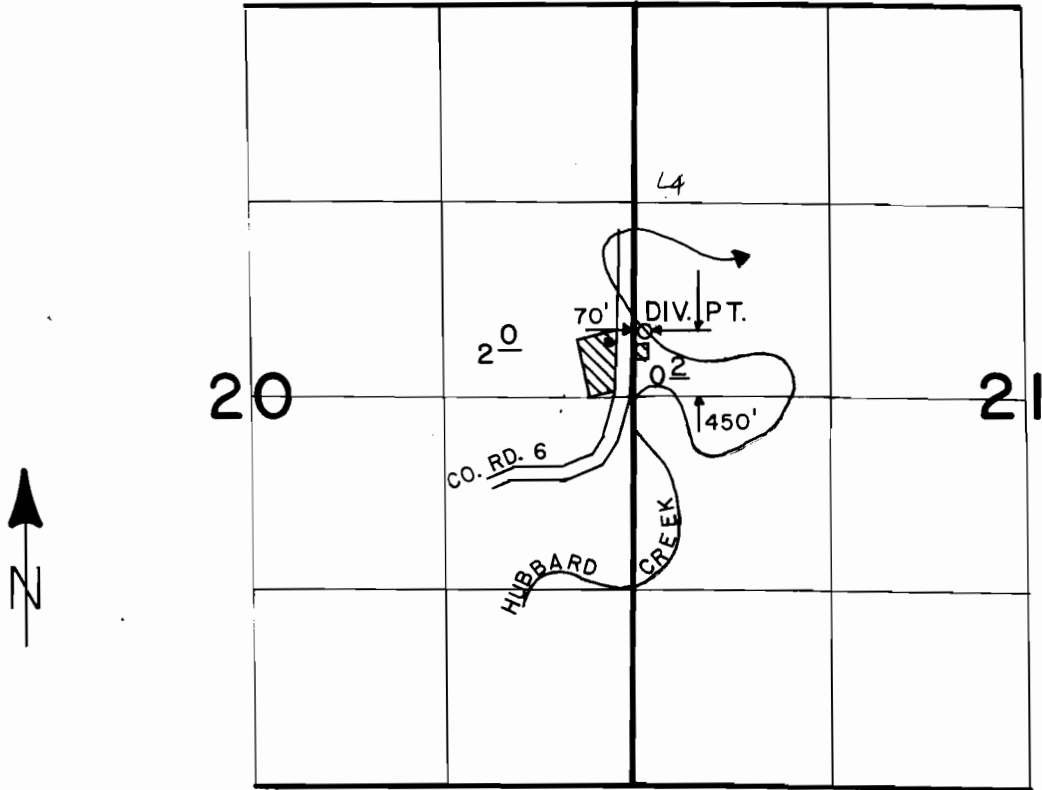

SCALE: 4" = 1 MILE

## FINAL PROOF SURVEY UNDER

Application No. 50871... Permit No. 37387.....  
IN NAME OF

MR. & MRS. HENRY BREI.....

Surveyed OCT. 13... 1987, by J.M. SCHMORDE.