


T. 3 S., R. 3 W., W.M.

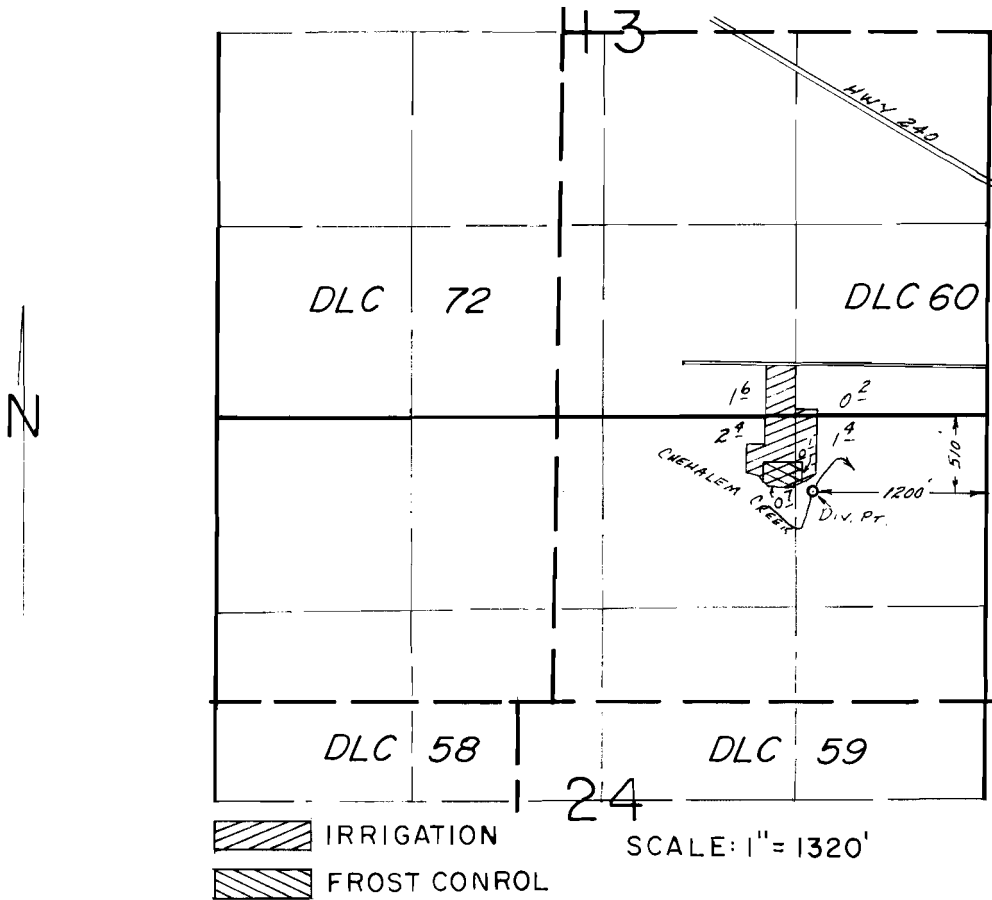

**FINAL PROOF SURVEY**  
UNDER

Application No. 50627... Permit No. 37498.....  
IN NAME OF

WAYNE & ETHEL A. SELIVANOW.

Surveyed Nov. 13.... 1987., by B.W. BISHOP.....