


T. 22 S., R. 8 W., W. M. SECTION 21

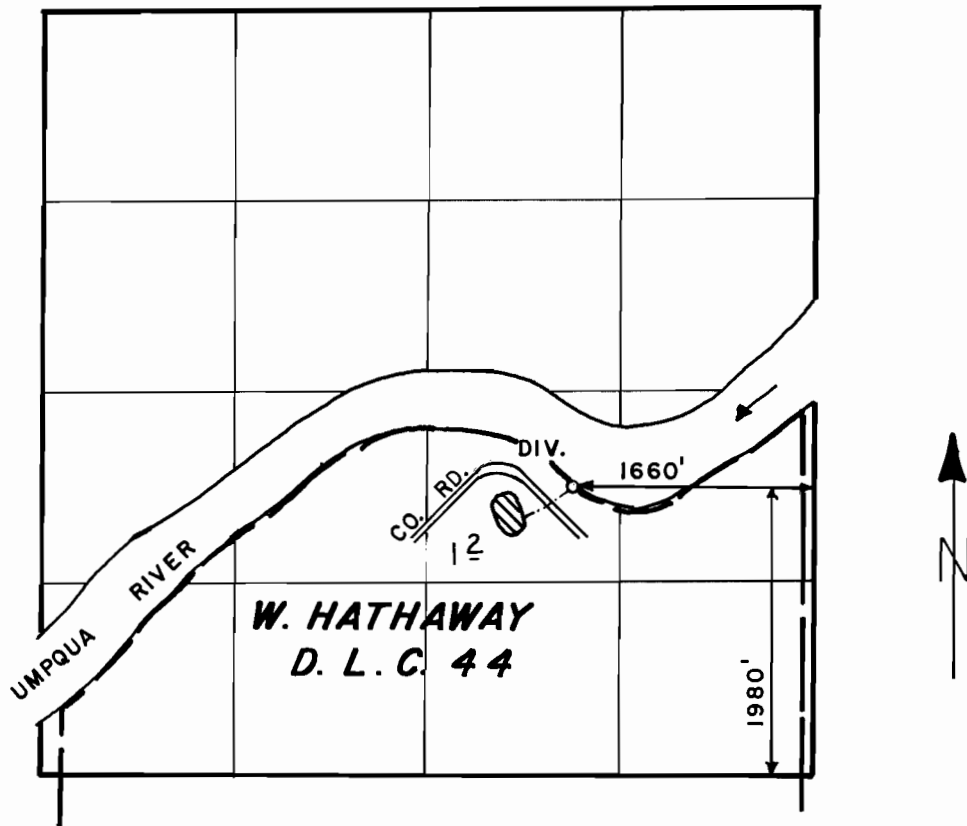

SCALE: 4" = 1 MILE

FINAL PROOF SURVEY UNDER

Application No. 49905 Permit No. 37554
IN NAME OF

SHERMAN H. TALBOT

Surveyed SEPT. 15 1987, by J. M. SCHMORDE