


T.37S., R.9W., W.M.

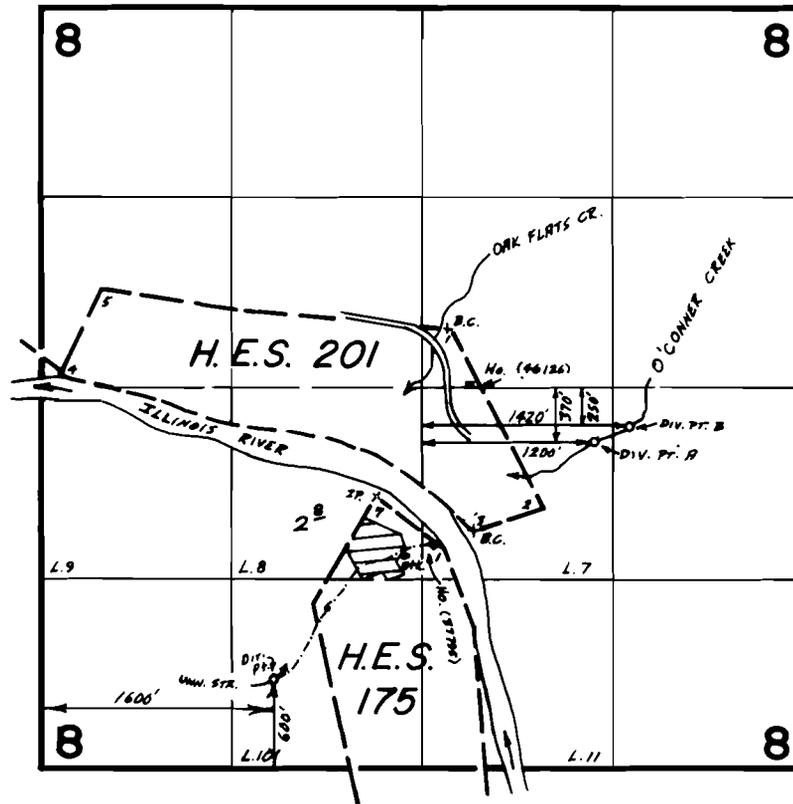

Scale 1"=1320'

FINAL PROOF SURVEY
UNDER

52266 37795
Application No. 61274... Permit No. 46126.....

IN NAME OF

.....DOLORIS M. LLOYD.....

Surveyed Aug. 10... 1984, by B.S. JAMES.....