


T.37S., R.9W., W.M.

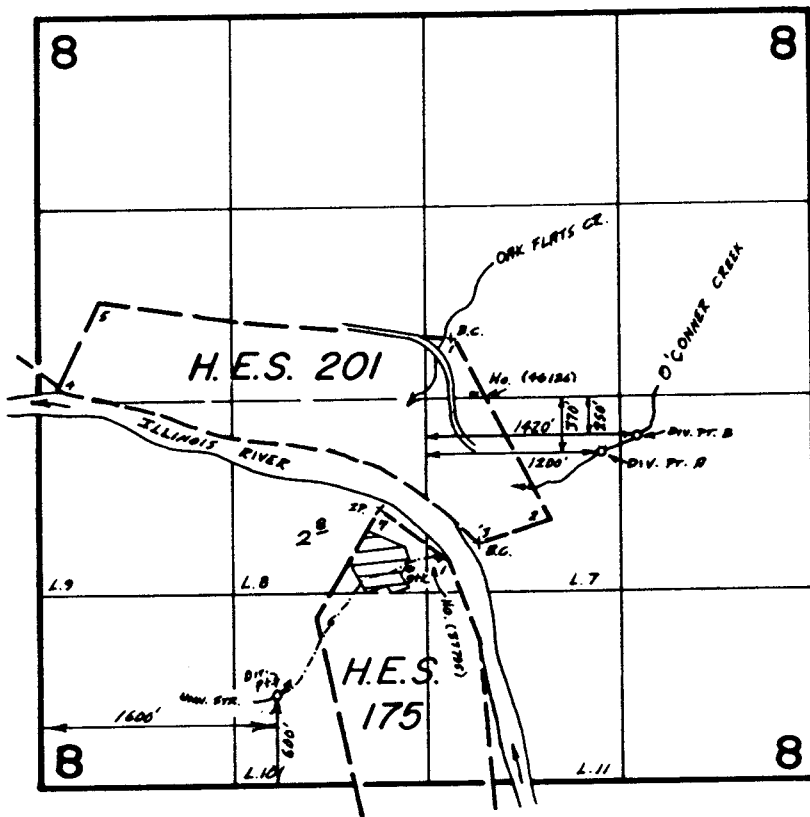

RECORDED

JUL 20 1989

BY [illegible]

Scale 1"=1320'

FINAL PROOF SURVEY
UNDER

52266 37795
Application No. 61274... Permit No. 46126.....
IN NAME OF

DOLORIS M. LLOYD

Surveyed Aug. 10, 1984, by B.S. JAMES.....