





T. 39 S., R. 24 E., W.M.

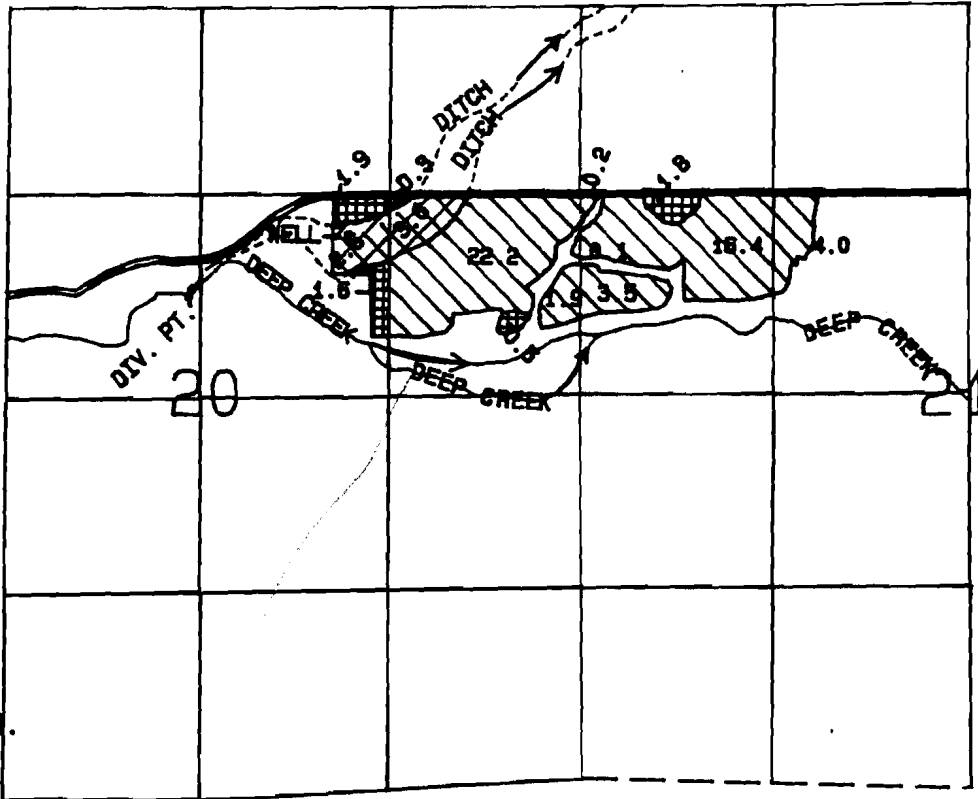

-  SUPPL. WELL
-  PRIM. DEEP CR.
-  PRIM. WELL

WELL LOCATED 1000 FT. E. AND 1560 FT. S. FROM N. 1/4. COR. SEC 20
 DIV. PT. LOCATED 100 FT. W. AND 1910 FT. S. FROM N. 1/4 COR. SEC 20

FINAL PROOF SURVEY

UNDER

APPLICATION NO. 6-10448 PERMIT NO. 6-9613
 51693 38974

IN NAME OF

NOLAN & LOIS GRIENER

SCALE: 1 IN. = 1320

Surveyed Oct. 18, 1987 By V.L. CHURCH

Photo: 3KK-194 DLM