


T. 37 S., R. 3 W., W.M.

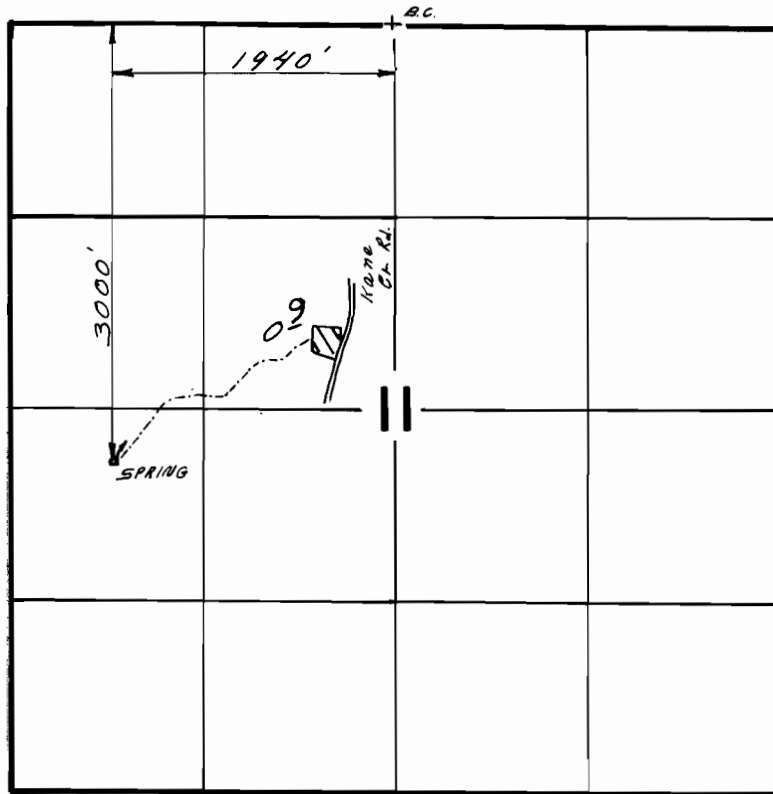

Scale 1" = 1320'

FINAL PROOF SURVEY UNDER

Application No. 52052. Permit No. 39228.....
IN NAME OF

PAUL...D....and...or...SARAH...J....WYRICK.

Surveyed July 28, 1987, by B.S. JAMES.....