


T. 5 S., R. 7 W., W.M.

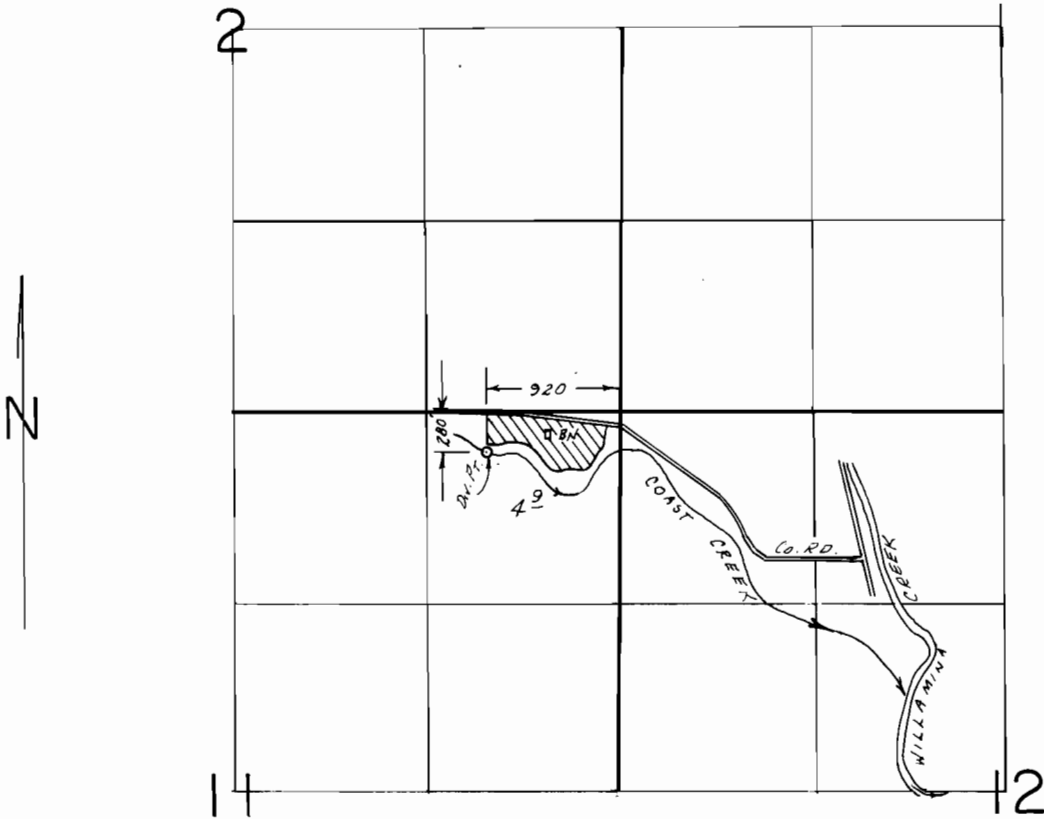

SCALE: 1" = 1320'

**FINAL PROOF SURVEY**  
UNDER

Application No. 52944.. Permit No. 39972.....  
IN NAME OF

..... J. F. LOGGING CO. ....

Surveyed July 7... 19.87, by B.W. BISHOP.....