




T. 23 S., R. 13 W., W.M.

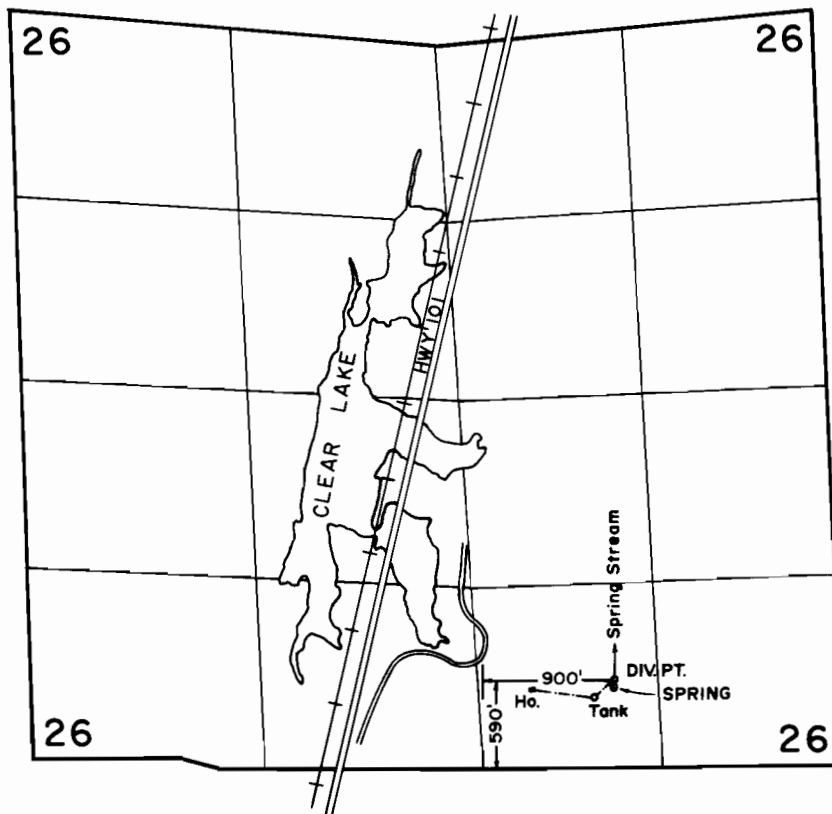

SCALE: 1" = 1320'

**FINAL PROOF SURVEY**  
UNDER

Application No. 53708. Permit No. 40150.....  
IN NAME OF

.....THEODORE F. RITCHIE.....

Surveyed SEPT. 17, 1988, by V. L. CHURCH.....