


T.5S., R.7W., W.M.

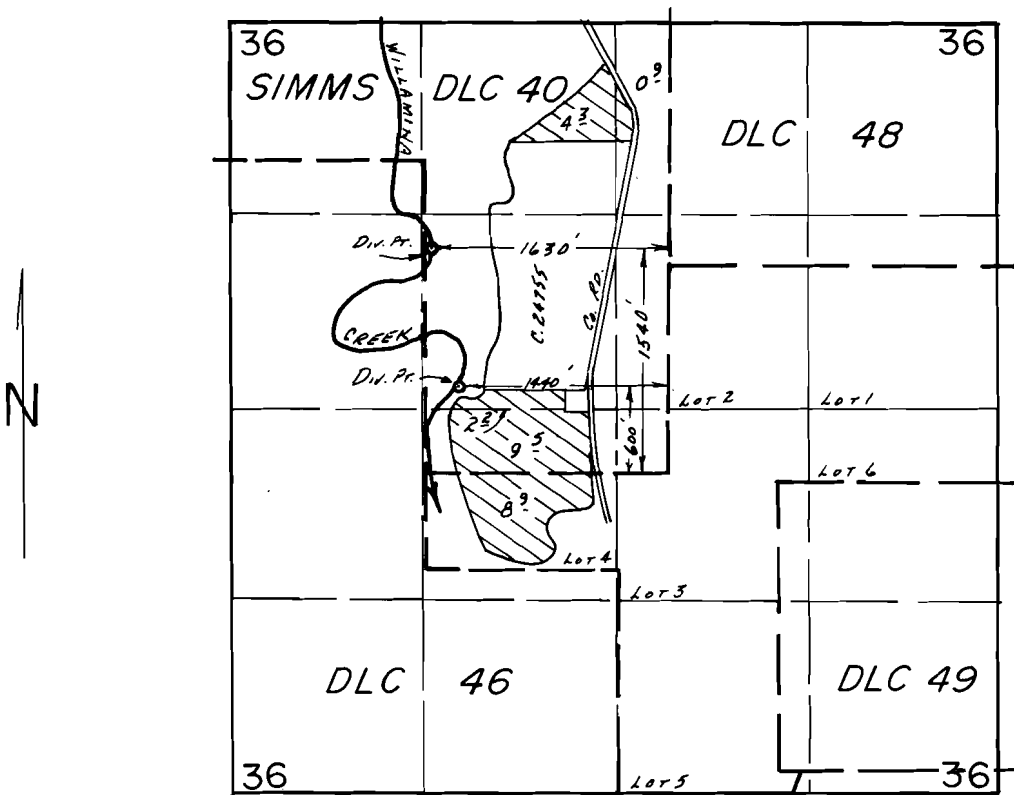

SCALE: 1" = 1320'

FINAL PROOF SURVEY
UNDER

Application No. 54759. Permit No. 41076.....
IN NAME OF

.....PATRICIA STONE.....

Surveyed Nov. 2, 1984, by P. PAGTER.....
Sept. 18, 1987, B.W. BISHOP

3/2/89
AWB
41071-178-2L