


# T. 23 S., R. 13 W., W.M.

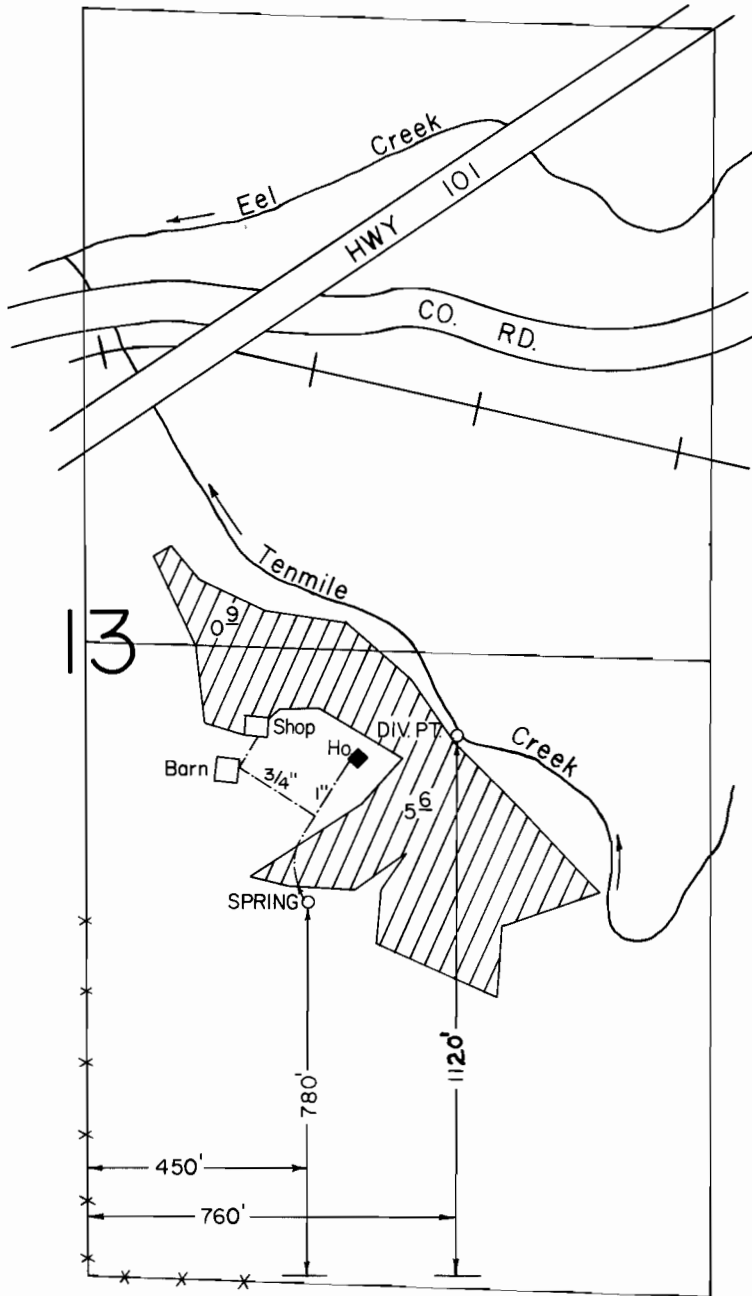

SCALE: 1" = 400'

## FINAL PROOF SURVEY UNDER

Application No. 55466.. Permit No. 41830.....  
IN NAME OF

DARYL D. & LOUISE A. WILDER

Surveyed SEPT. 18, 1988, by V.L. CHURCH.....