


T.14S., R.15E., W.M.

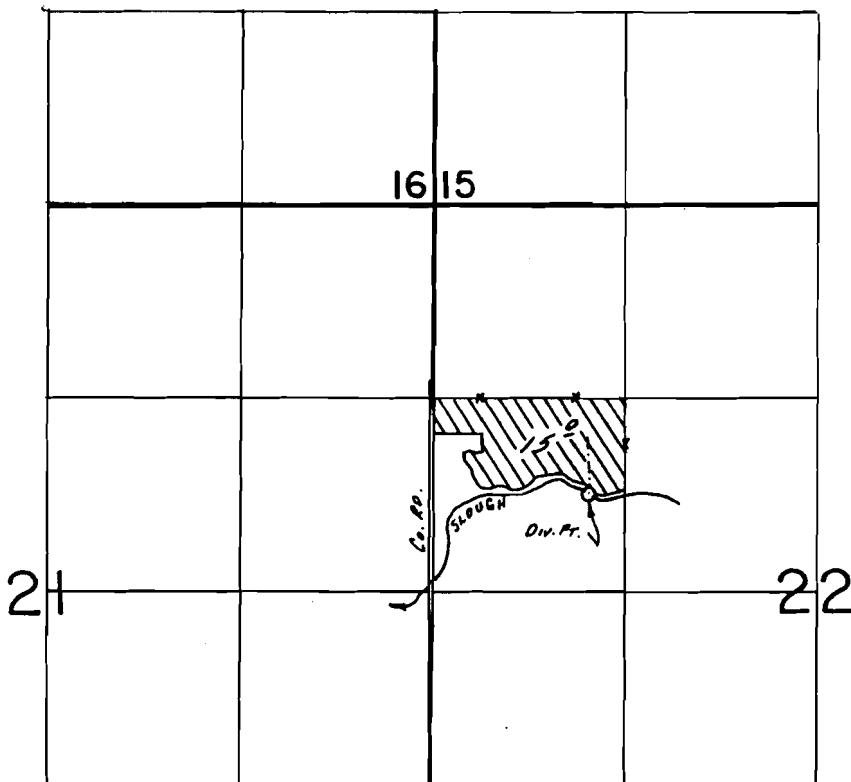

Div. Pt. Loc.: 1970 S. & 1080 E. FROM NN COR. SEC. 22.

SCALE: 1" = 1320'

FINAL PROOF SURVEY UNDER

Application No. 56067... Permit No. 42329...
IN NAME OF

cert. # 61805

.....WILLARD L. POWELL.....

Surveyed May 11..... 1987., by M.J. MATTICK.....

RECEIVED

DATE 8-8-89

WATER MASTER DISTRICT #11

BY JMS

3/9/88 JWB

PCY-04-112

42329