
90684

T. 40 S., R. 13 W., W. M.

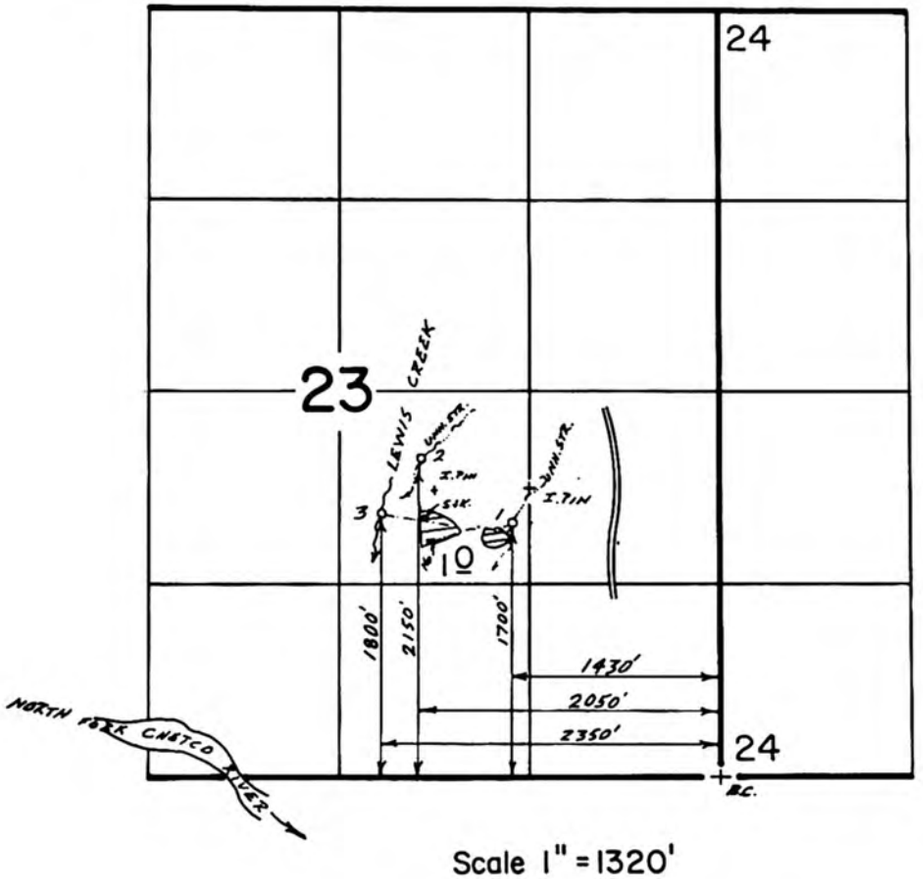

Scale 1" = 1320'

N

FINAL PROOF SURVEY

UNDER

Application No. 56141 Permit No. 42803

IN NAME OF

EMILE & RUBY DANGREAU

Surveyed Oct. 11 1988, by B.S. JAMES

41011-180-141A