


T.8S.,R.46E.,W.M.

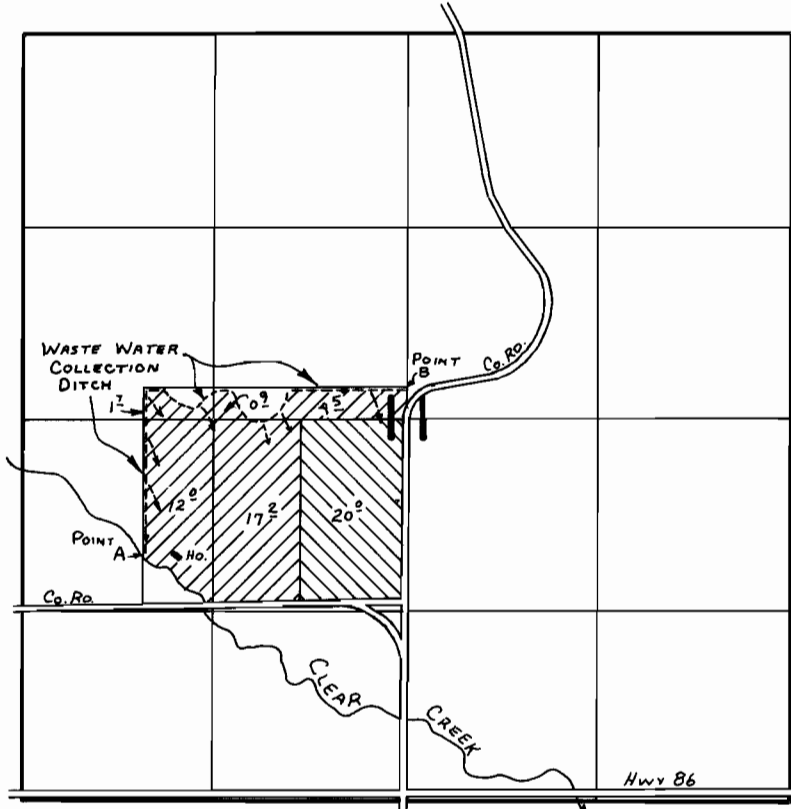

DIV. PT.—at any point along waste water collection ditch between Point A (900 ft S & 1800 ft W from Center Sec II) and Point B (230 ft N from Center Sec II).

SCALE: 1" = 1320'

FINAL PROOF SURVEY

UNDER

 Primary

 Supplemental

Application No. ..51715... Permit No. ...42935.....

IN NAME OF

.....KENNETH WHEELER.....

Surveyed ..Sept..26.. 19.85., by ..L..M..TOLL.....