


**T.39S. R.3W. W.M.**

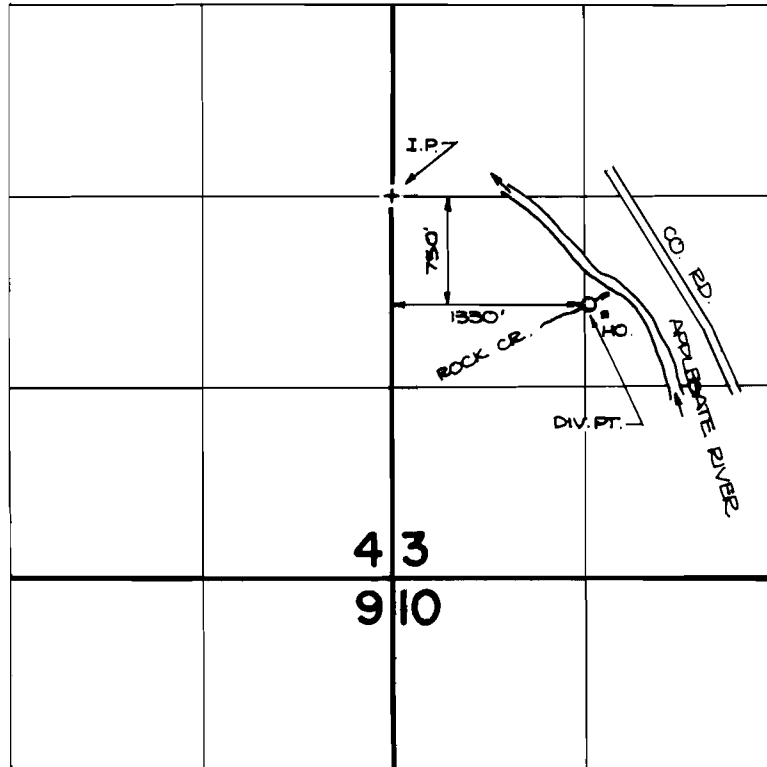

**FINAL PROOF SURVEY**  
UNDER

Application No. 57124. Permit No. 42954...  
IN NAME OF

.....**KENNETH PHILLIPS**.....

Surveyed **MAY 19**, 19**83**, by **B. JAMES**.....