




T.23S.,R.13W.,W.M.

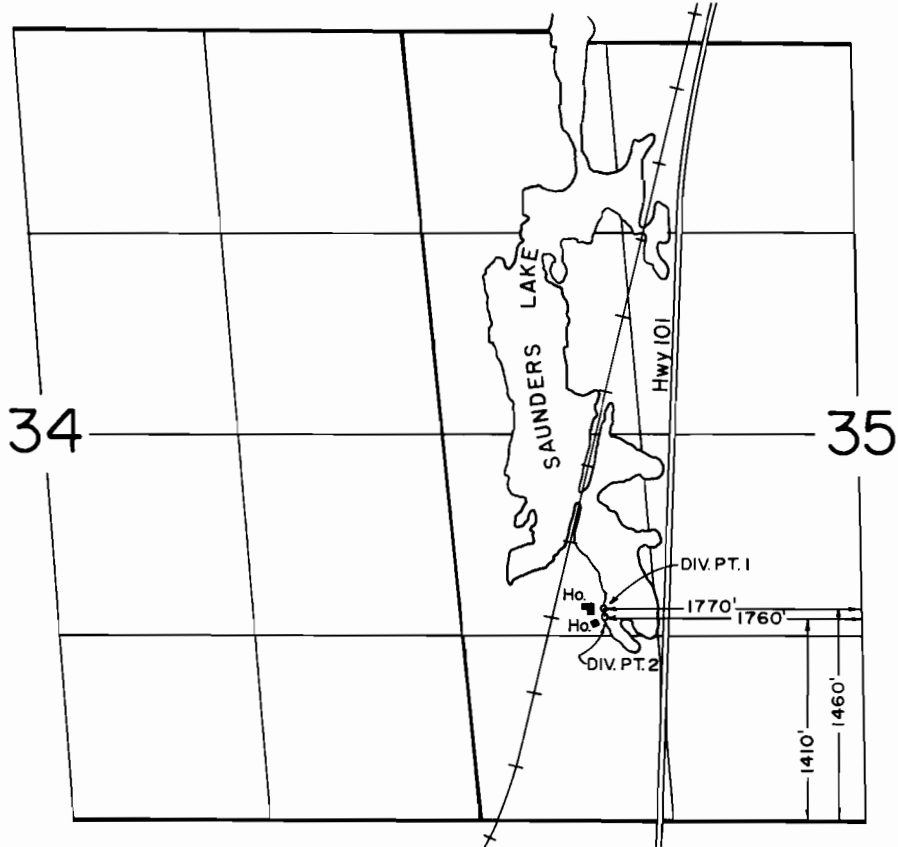

SCALE: 1" = 1320'

FINAL PROOF SURVEY
UNDER

57805 43557
Application No. 57806... Permit No. 43558.....
IN NAME OF

HAROLD L. KIRK

Surveyed SEPT. 17, 1988, by V. L. CHURCH