


43664
16181

SEC. 15 SEC. 10
OFC LAND

3
OFC LAND

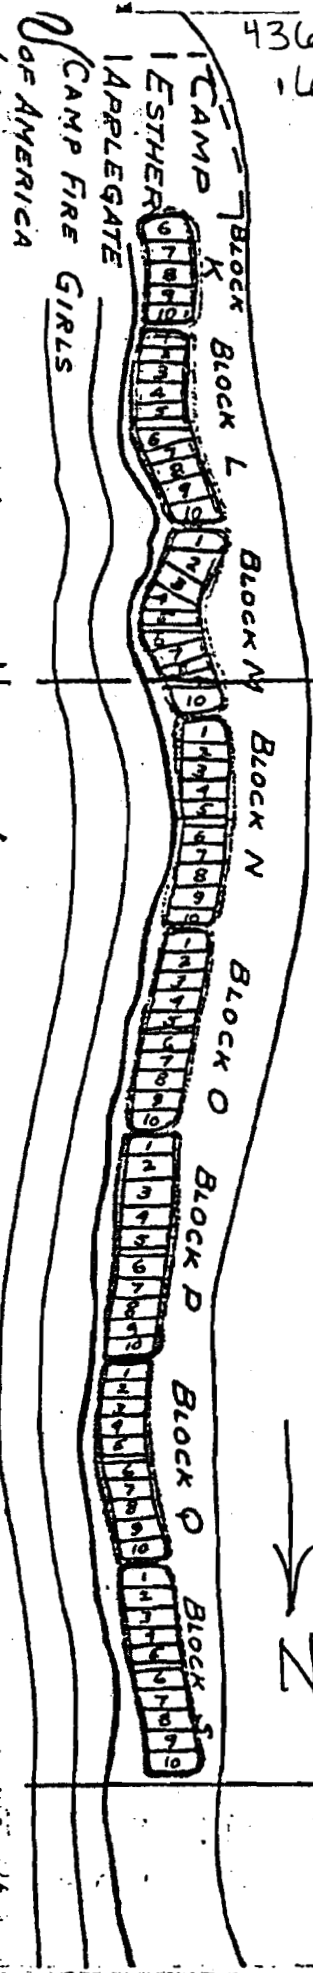


*Point of diversion is
469th S. and 264th E. of
The W 1/4 corner of
Sec. 11, T. 37S., R. 5E., W. 1/4.*

LAKE OF THE WOODS

RECEIVED
OCT 12 1978
WATER RESOURCES DEPT.
SALEM, OREGON

Application No. 57989
Permit No. 43664

Point of diversion

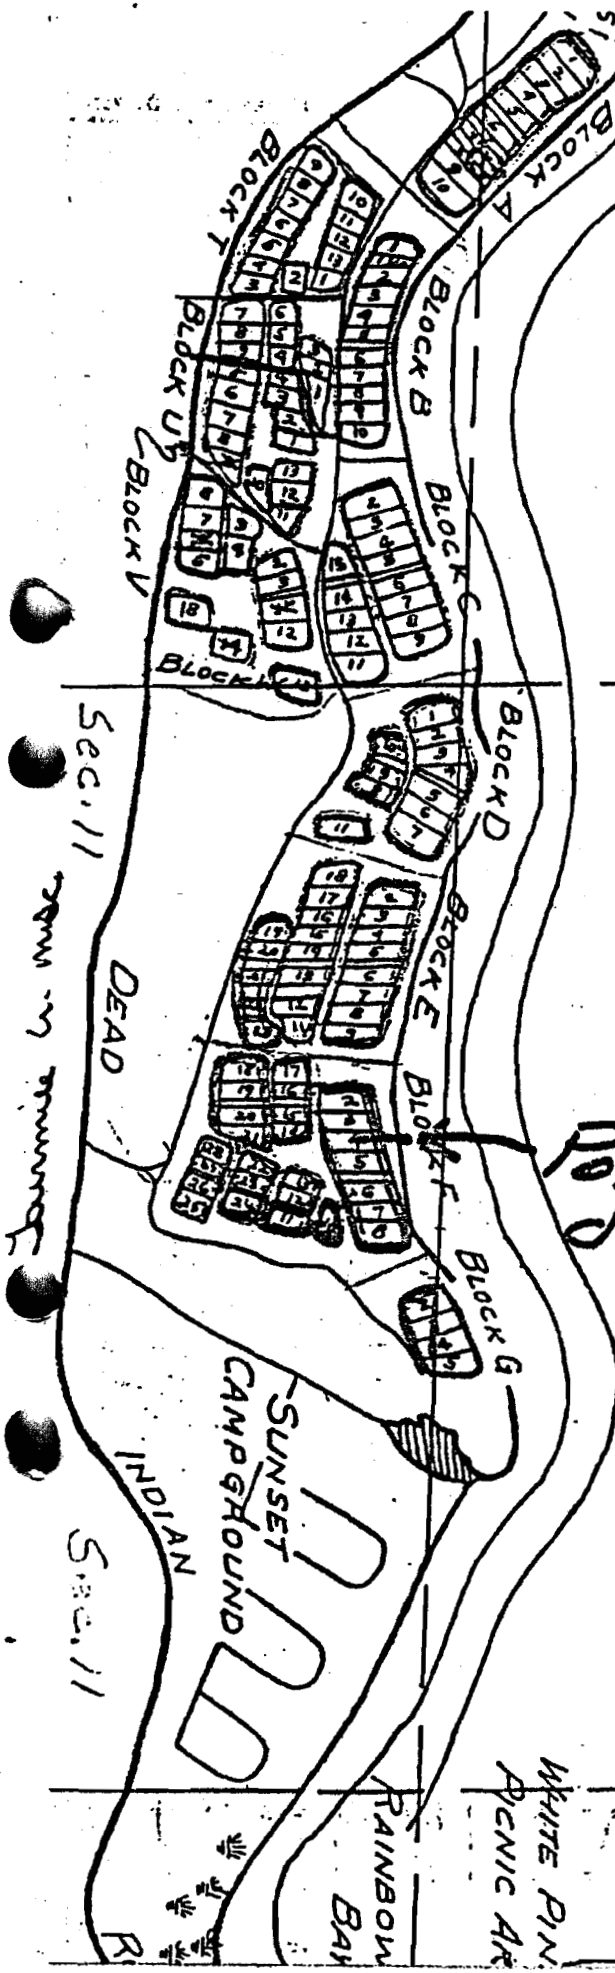

Sec. 11
Sec. 11
Sec. 11