




T. 27 S., R. 11 W., W.M.

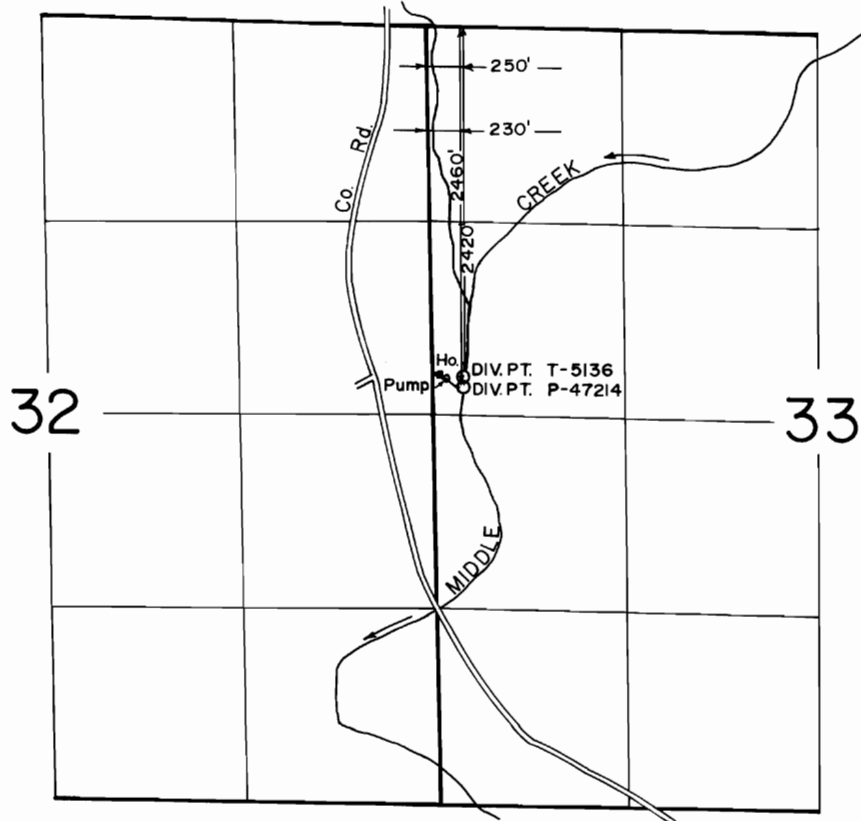

SCALE: 1" = 1320'

FINAL PROOF SURVEY
UNDER

Transfer No. 5136

Application No. 58003 Permit No. 47214
IN NAME OF

RICHARD G. & SUSAN J. LEMERY

Surveyed SEPT. 18, 1988, by Z. SALEH