


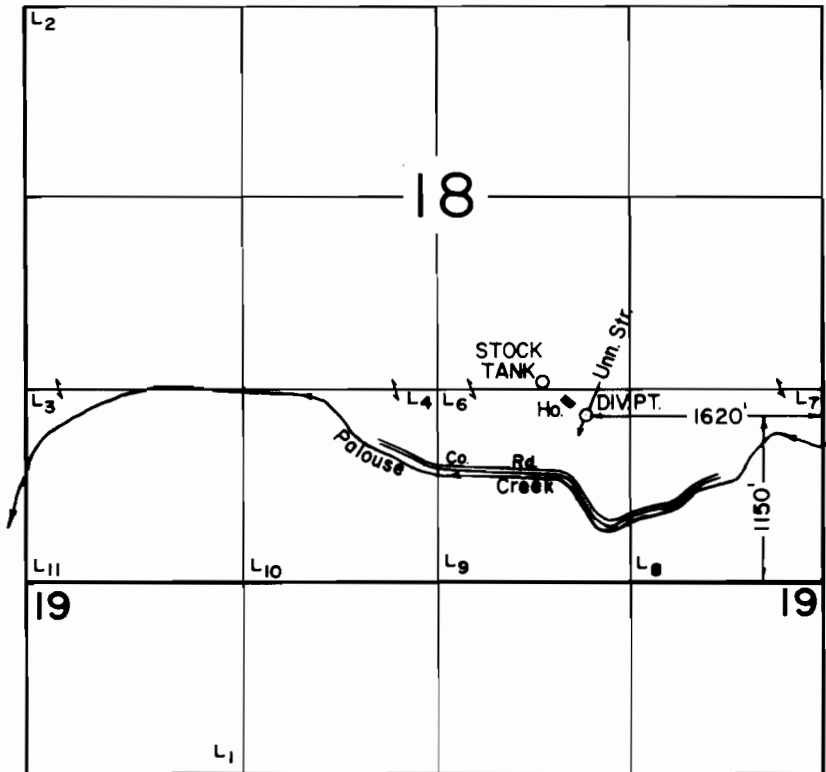

T.24S.,R.12W.,W.M.



SCALE: 1" = 1320'

**FINAL PROOF SURVEY**  
UNDER

Application No. 58081... Permit No. 43802...  
IN NAME OF

RICHARD P. & PAMELA L. GLEASON

Surveyed SEPT. 21, 1988, by V. L. CHURCH...