


T.1S.R.10&11W.W.M.

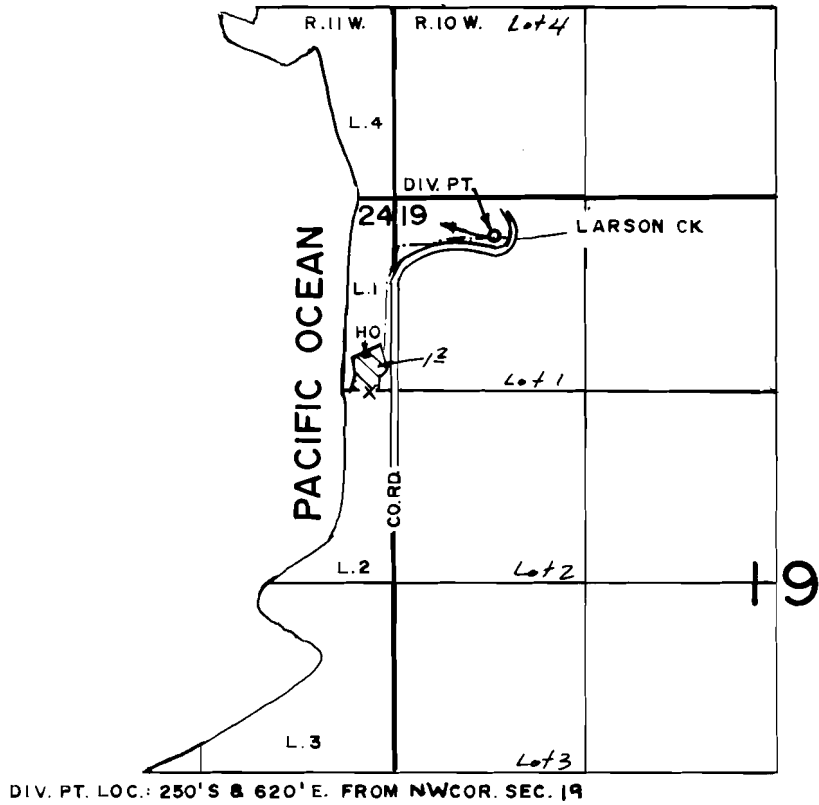

FINAL PROOF SURVEY UNDER

Application No. 58441 Permit No. 44028.....
IN NAME OF

.....HELEN L WOOD.....

Surveyed FEB. 12. 1980, by R.G. MUCKEN.....