


# T. 18 S., R. 46 E., W.M.

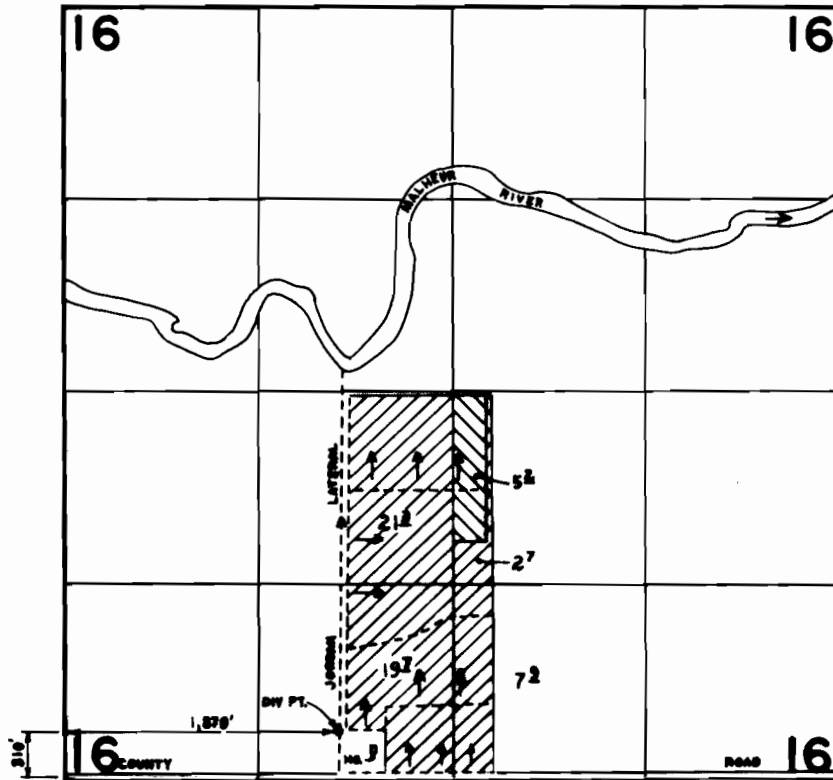

P# 44422    
  T-2824

1" = 1,320'

## FINAL PROOF SURVEY UNDER

Application No. ~~58537~~..... Permit No. ~~44422~~.....  
IN NAME OF

**TUCKER, CHARLES G. & MARY A.**

Surveyed ~~MAR...A...~~ 1986., by ~~J.M. IQL~~.....