


T.9S.,R.6W.,W.M.

Application No. 59241  
Permit No. 44395

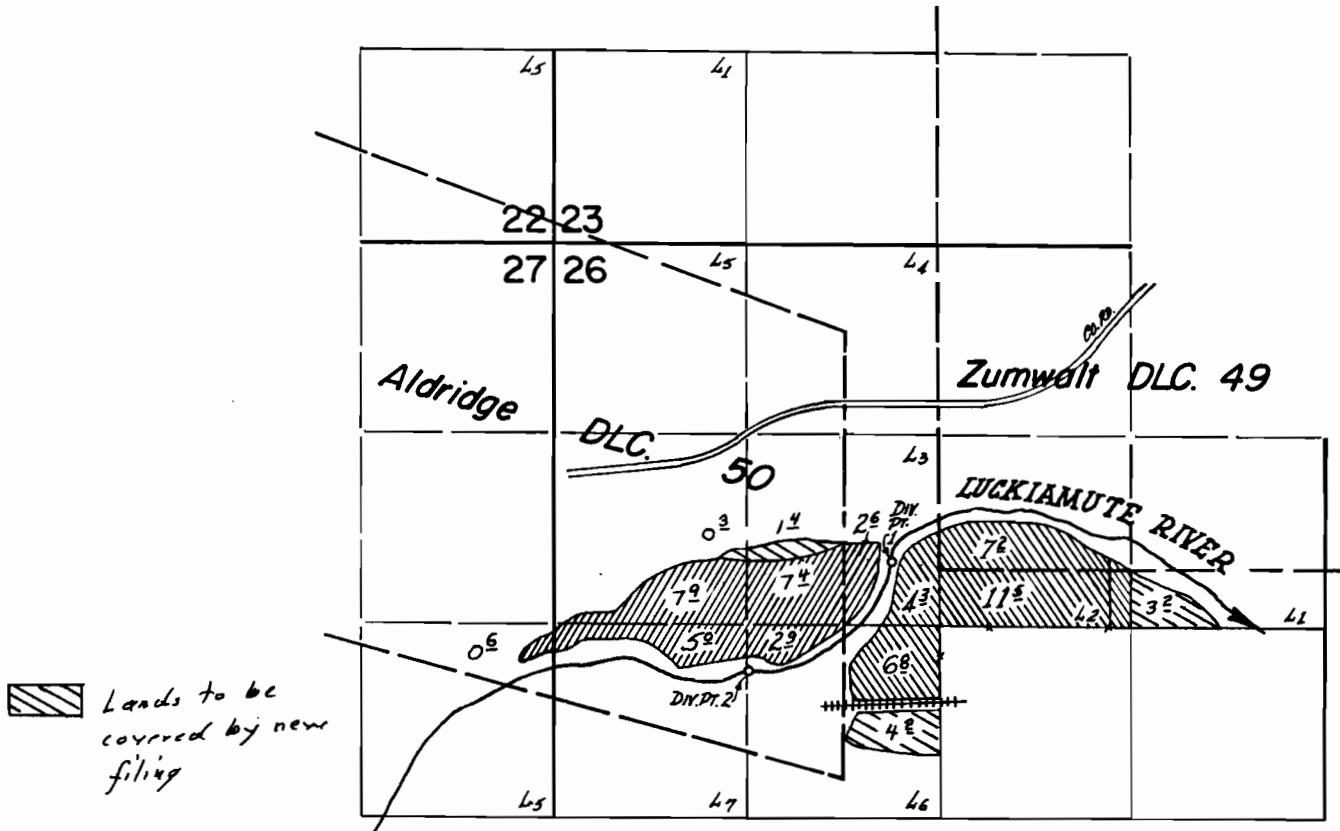

Dir. Pt. 2, loc. 330'S + 1300'W. from center of Sec. 26.

Dir. Pt. 1, loc. 430'N. + 320'W. from center of Sec. 26.

**FINAL PROOF SURVEY**  
UNDER

Transfer No. 2976

Application No. .... Permit No. ....  
IN NAME OF

..... MARY ISABEL WEISENSEE .....

Surveyed July 6... 1911... by L.M. TOLL .....